


Section 12 Township 18 Range 8-W

Well No. #4 A. Johnson

Company Continental

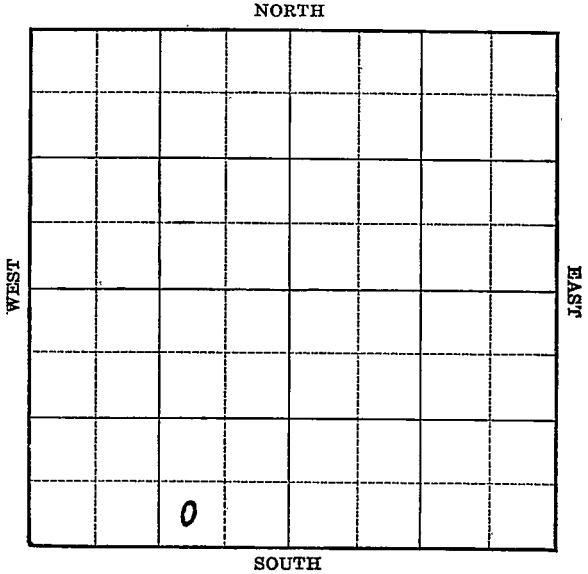

Sec. 12 Twp. 18 R. 8-W

Well No. #4 A. Johnson Farm

Continental Company


(Geneseo)

\_\_\_\_\_ Ft. from N. Line

330 Ft. from S. Line

990 Ft. from E. Line

\_\_\_\_\_ Ft. from W. Line

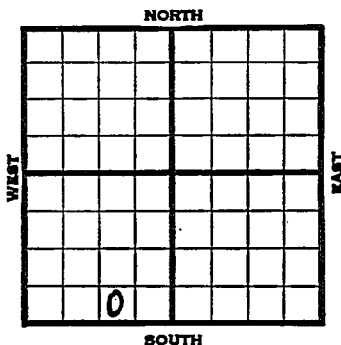

1939	REPORT
12/6	11" - 216'
	Drig. 2764'
12/14	Arb. <del>3179</del> <sup>3192</sup> 7" - <del>3180</del> <sup>3192</sup> '
	T.D. 3182' RUST.
12/21	Arb. 3192' (Corrected)
	7" - 3192' "
	T.D. 3234' RUST. 3050' oil.
12/27	Arb. 3192'
	7" - 3180'
	T.D. 3234'
	2000 acid.
	Depthograph potential 13,140 bbl
	Maximum 3000 bbls.
1955	COMPLETED
	O.W.W.O
9-21	Old Info- OTD 3233, OPBTD 3175, was Arb. prod, Top of Penn Cong 3160.7" 3180 New info: Sq Arb OH 3190-3233 w/100 CO 3175, perf 48/3160-72 frac P 87 bo plus tr of wtr complete, P 25 bond, Penn Cong perf 3160-72, grav 38° TD3233 PBTD 3175 # A 3193
	FIRST REPORT COMPLETED





# O.W.W.O.

O.W.W.O.

FORM 513 REV. SUNRAY

County Rice Elev. 1754 RB  
 Sec. 12 Twp. 10 Rge. SW  
 Company Continental Oil Co.  
 Farm Name A. H. Johnson No. 4

TOPS	DEPTH	LOG	DATUM	Loc. in Sec. <u>OTD 3233</u>																	
Anh.				<u>Sw Sw Sw</u>																	
Tr.																					
H.																					
Tr.																					
Dg.																					
Bl.																					
L.																					
K.C.			Geol.																		
B.K.C.			Contr.																		
Ce.																					
C.																					
M.			Pool																		
M.																					
K.																					
Mz.																					
Ma.			Geneseo																		
V.			<table border="1" style="width: 100%; height: 100px;"> <tr><td></td><td></td><td></td></tr> <tr><td></td><td></td><td></td></tr> <tr><td></td><td></td><td></td></tr> <tr><td></td><td></td><td></td></tr> <tr><td></td><td></td><td></td></tr> <tr><td></td><td></td><td></td></tr> </table>																		
S.																					
S.																					
A.	3193		FIRST REPORT																		
R.			COMPLETED																		
Pe.																					
G.																					
TD.	3233																				

Date Comm. \_\_\_\_\_

SEP 21 1955

Old info - OTD 3233, OPBTD 3175, was Arb. prod, Top of Penn Cong 3160, 7" 3180

New info - Sq Arb OH 3190-3233 w/100 CO 3175, perf 48/3160-72 frac P 87 be plus - tr of wtr complete, P 25 bopd, Penn Cong perf 3160-72, gravity 38°, TD 3233, PBTB 3175

Co. No. Sec. T. R.