


Section 12 Township 18 Range 8-W

Well No. #5 Johnson

Company Continental et al

NORTH **Edwards Pool**

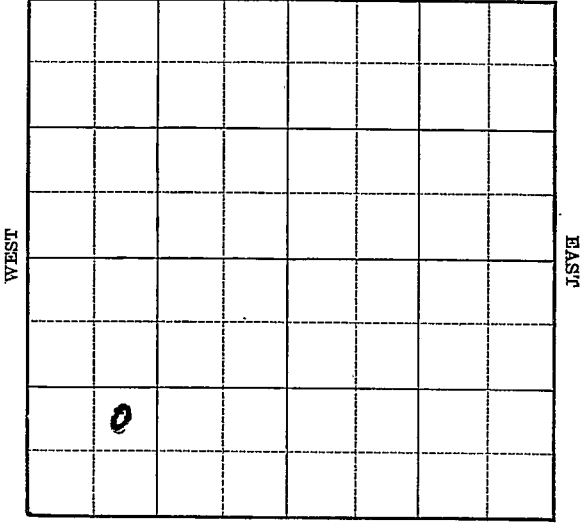

SOUTH

Map No. 45 Sec. 12 Twp. 18 R. 8WWell No. 5 JohnsonContinental etal Company

Contractor

FIRST REPORT

SECTION PLAT

NE SW SW

 Ft. from N. Line990 Ft. from S. Line Ft. from E. Line990 Ft. from W. Line

o			

EDWARDS POOL

Location XRig up

Drilling and Remarks:

RECORD

Cased in., ft.Sand Gas Oil Total Depth

PRODUCTION

1st 24 hrs. Nat. 1st 24 hrs. after shot Gas Cu. Ft.Dry Hole Abandoned

Date

APR 24 1940 19S. J. LEWIS Scout

