

Rice
8W

Map No. **KANSAS** Sec. *13* Twp. *18* R. *8W*

Well No. *1- Michel* Farm _____
Continental & Empire Company


_____ Ft. from N. Line

990 Ft. from S. Line

_____ Ft. from E. Line

990 Ft. from W. Line

Elev. 1717

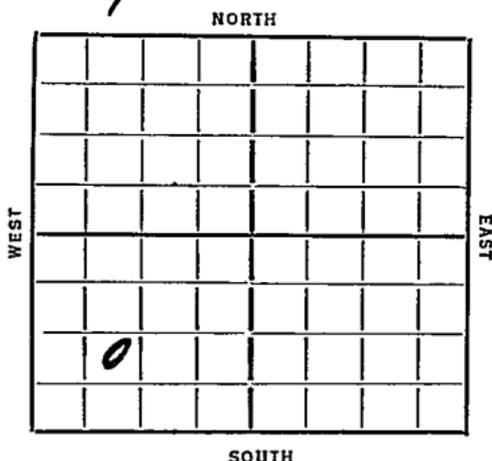

REPORT

~~1/25~~
1/22 Location
1/31 BK
2/7 Run 12" 165
2/14 Ann Cave 2/20
2/21 8" 1357 WOC
2/28 Coing 3167.
3/6 Art 3210-14
5/4 3210 Rust
3/12 Top Siliceous 3210
TD 3214
2500 feet Oil 2 hrs (2el)
3/19 SD for tanks
3/20 Swabbed 75 bbls. acidizing.
3/27 Pumped 883- 24 hours. Retesting.
4/2 --
4/10 --
4/15 Oil 3210
TD 3216
potential 1428.

COMPLETED

Map No. 45 Sec. 12 Twp. 18 R. 8W

Well No. 1-Nickel

Continental & Empire Company

Contractor

SECTION PLAT

..... Ft. from N. Line

990 Ft. from S. Line

..... Ft. from E. Line

990 Ft. from W. Line

FIRST REPORT

Location ✓

Rig up

Drilling and Remarks:

RECORD

Cased..... in., ft.

Sand.....

Gas.....

Oil.....

Total Depth.....

PRODUCTION

1st 24 hrs. Nat.....

1st 24 hrs. after shot.....

Gas..... Cu. Ft.

Dry Hole.....

Abandoned.....

Date

JAN 5 1936

192

Scout

ORVAL MANNSCHECK

Map No. 45 Sec. 13 Twp. 18 R. 8 W

Well No. 1 Nichols

Continental & Empire Company

Contractor

SECTION PLAT

..... Ft. from N. Line

990 Ft. from S. Line

..... Ft. from E. Line

990 Ft. from W. Line

COMPLETED

Location.....

Rig up.....

Drilling and Remarks:

Sil 3210

Potential

1425

RECORD

Cased..... in., ft.

Sand.....

Gas.....

Oil.....

Total Depth 3210

PRODUCTION

1st 24 hrs. Nat.....

1st 24 hrs. after shot.....

Gas..... Cu. Ft.

Dry Hole.....

Abandoned.....

Date

Apr. 10 1936

S. J. LEWIS

192.....

Scout