


Rice

Section 13 Township 18 Range 8-W

Well No. 1 Zagie


Company Shell

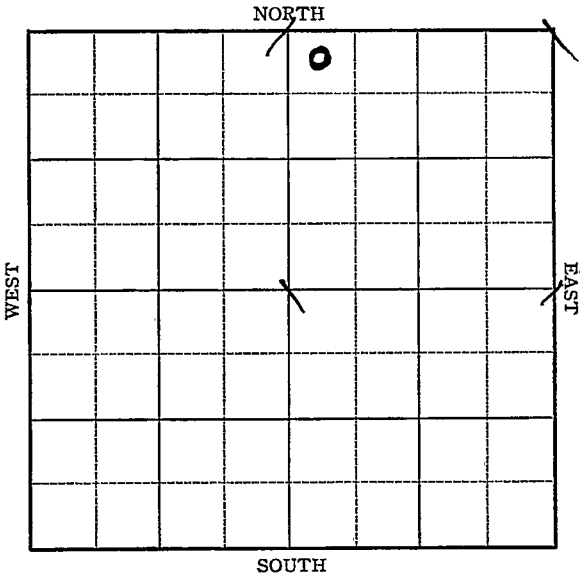

Sec. 13 Twp. 18 R. 8-W

Well No. #1 Zagie Farm
Shell Company

330 Ft. from N. Line
 _____ Ft. from S. Line
 _____ Ft. from E. Line
330 Ft. from W. Line

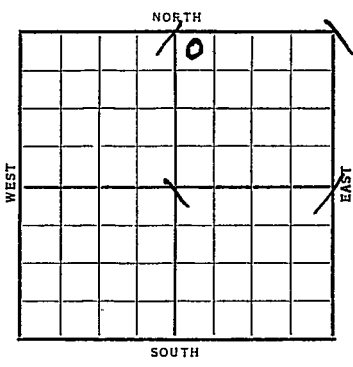

Elev. 1752

Date	REPORT
1937	
12/1	R. R.
12/3	"
12/10	S. H.
12/17	13" @ 250'. Drlg. 1530'.
12/24	Drlg. 3278'.
12/31	Lansing 2791'. Stain oil 2861
	-2867'. Arb. 3157'. 7" @ 3158'.
	Cored 3158-63'. Recovered 3'
	Sat. RUST.
1938	
1/7	T.D. 3242'. 3000' oil.
1/12	7" @ 3158'.
	Arb. 3157'.
	T.D. 3242'.
	Potential 2331 bbls., Nat.
	COMPLETED

KANSAS

Rice

Map No. 45 Sec. 13 Twp. 18 R. 8WWell No. 1 ZagieShell Company

Contractor

FIRST REPORT

NW NE

330 Ft. from N. Line

_____ Ft. from S. Line

_____ Ft. from E. Line

330 Ft. from W. Line

SECTION PLAT

		0	

Location _____

Rig up _____

Drilling and Remarks:

RR

RECORD

Cased _____ in., _____ ft.

Sand _____

Gas _____

Oil _____

Total Depth _____

PRODUCTION

1st 24 hrs. Nat. _____

1st 24 hrs. after shot _____

Gas _____ Cu. Ft.

Dry Hole _____

Abandoned _____

Date

DEC 1 - 1937

19

H. D. Hatfield

Scout

Rice KANSAS

Map No. 45 Sec. 13 Twp. 18 R. 8W

Well No. 1 Zagie

Shell Company

Contractor

COMPLETED

NW NE

SECTION PLAT

		0	

330 Ft. from N. Line

_____ Ft. from S. Line

_____ Ft. from E. Line

330 Ft. from W. Line

Location _____

Rig up _____

Drilling and Remarks:

POT - 2331
NAT,

RECORD

Cased 7 in., 3158 ft.

Sand 456 3157

Gas _____

Oil _____

Total Depth 3242

PRODUCTION

1st 24 hrs. Nat. _____

1st 24 hrs. after shot _____

Gas _____ Cu. Ft.

Dry Hole _____

Abandoned _____

Date

JAN 12 1938

19

H. D. Hatfield Scout