


Section 13 Township 18 Range 8W

Well No. #1 W. Zajic

Company Shell

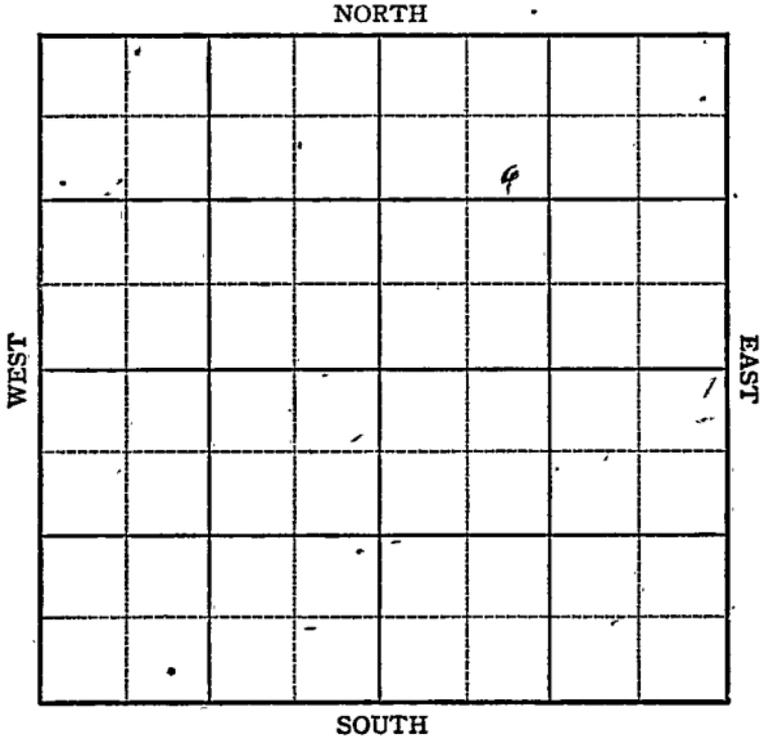

Sec. 13 Twp. 18 R. 8-W

Well No. 1 W. Zajic Farm

Shell Company


Rice County

992 Ft. from N. Line

_____ Ft. from S. Line

_____ Ft. from E. Line

1200 Ft. from W. Line

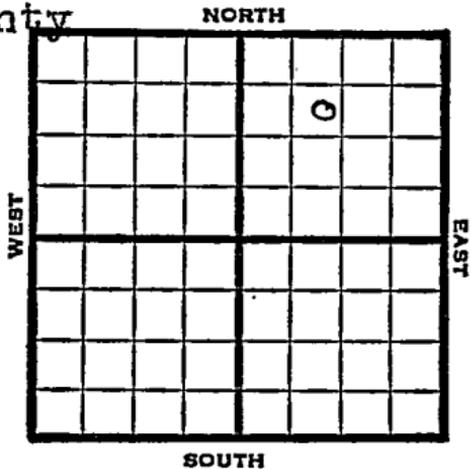

SE NW NE

1947 Ele 1737 REPORT

⁵
~~2-11~~ 10" @ 257
Drlg. 360
Twin Well

2/12 Drlg 3075

2/19 Arb. 3192'
7" @ 3300
SWD
TD 3784'

ABANDONED

Map No. 45 Sec. 13 Twp. 18 R. 8W

Well No. 1 W. Zajic

Shell Company

FIRST REPORT

Contractor _____

SE NW NE

SECTION PLAT

992 Ft. from N. Line

_____ Ft. from S. Line

_____ Ft. from E. Line

1200 Ft. from W. Line

		o	

Rice County

Location _____

Rig up _____

Drilling and Remarks:

10" @ 257
drlg. 360

Iron Well

RECORD

Cased _____ in., _____ ft.

Sand _____

Gas _____

Oil _____

Total Depth _____

PRODUCTION

1st 24 hrs. Nat. _____

1st 24 hrs. after shot _____

Gas _____ Cu. Ft.

Dry Hole _____

Abandoned _____

Date

FEB 5 1947

S. J. LEWIS Scout

Is this a term

Is this a term
will
advised
Sam

Misc. Small Maps	<input checked="" type="checkbox"/>
Cards	<input checked="" type="checkbox"/>
Tracing	<input checked="" type="checkbox"/>
France Map	<input checked="" type="checkbox"/>
Southrough Map	<input checked="" type="checkbox"/>
Elevation	<input checked="" type="checkbox"/>
Biological Dept.	<input type="checkbox"/>
Plat Book	<input type="checkbox"/>

Map No. 215 Sec. 13 Twp. 18 R. 8WWell No. 1 W. ZajicShell

Company

ABANDONED

Contractor

SE NW NE

SECTION PLAT

992 Ft. from N. Line Ft. from S. Line Ft. from E. Line1200 Ft. from W. Line

		0	

Rice County

Location Rig up

Drilling and Remarks:


RECORD

Cased in., ft.Sand Gas Oil Total Depth 3287

PRODUCTION

1st 24 hrs. Nat. 1st 24 hrs. after shot Gas Cu. Ft.Dry Hole Abandoned

Date

FEB 19 1947 19S. J. LEWIS Scout