KANSAS


FORM 51 5M 2-38 TPCO.

Rice

Section 13 Township 18 Range 8-W

Well No. 2 Pickerill

Company Continental et al

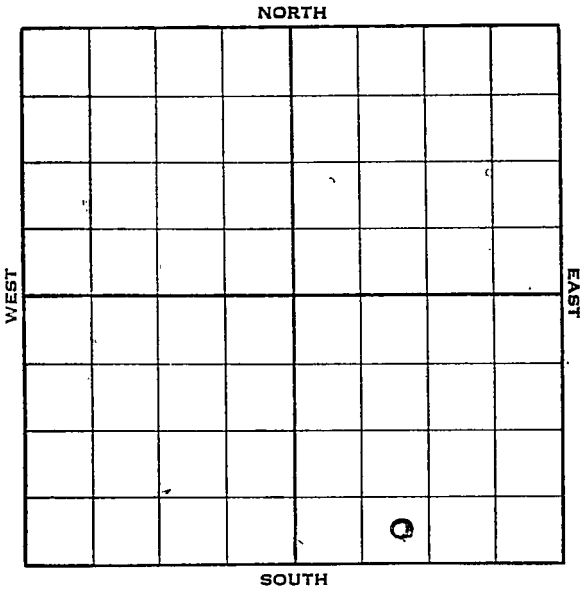


Form 252-A—5M—9-37 KANSAS Rice

Sec. 13 Twp. 18 R. 8-W

Well No. #2 Pickerill Farm

Continental et al Company

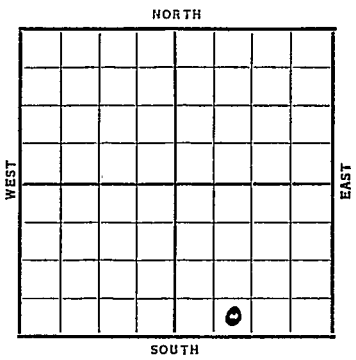

_____ Ft. from N. Line

330 Ft. from S. Line

_____ Ft. from E. Line

990 Ft. from W. Line

Elev. 1734'.8

Date	REPORT
1938	
2/9	Location
2/18	R U R
2/26	13" @ 222'. Drlg. 1745'.
3/4	Arb. 3219'. 7" @ 3220'.
	T.D. 3221'. RUST.
3/11	T.D. 3232'. 3100' oil.
3/16	7" @ 3220'.
	Arb. 3219'.
	T.D. 3232'.
	Potential 2157 bbls., Nat.
	COMPLETED

Form 26—1M Bks.—2-29 Rice KANSAS

Map No. Sec. 13 Twp. 18 R. 8W

Well No. 2 Pickerill

Continental etal Company

Contractor

FIRST REPORT

SE SW SE


Ft. from N. Line

330 Ft. from S. Line

Ft. from E. Line

990 Ft. from W. Line

SECTION PLAT

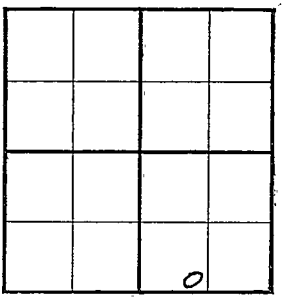

Location X

Rig up

Drilling and Remarks:

RECORD

Cased in., ft.

Sand

Gas

Oil

Total Depth

PRODUCTION

1st 24 hrs. Nat.

1st 24 hrs. after shot

Gas Cu. Ft.

Dry Hole

Abandoned

Date

FEB 9 1938 19

H. D. Hatfield Scout

Form 26—1M Bks.—2-29 Rice KANSAS

Map No. 45 Sec. 13 Twp. 18 R. 8W

Well No. 2 Pickerill

Continental etal Company

Contractor

COMPLETED

SE SW SE


Ft. from N. Line

330 Ft. from S. Line

Ft. from E. Line

990 Ft. from W. Line

SECTION PLAT

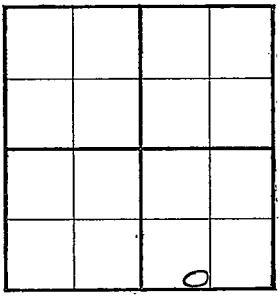

Location

Rig up

Drilling and Remarks:

Pot 2157

N GT

RECORD

Cased 7 in., 3220 ft.

~~Sand~~ Arb 3219

Gas

Oil

Total Depth 3232

PRODUCTION

1st 24 hrs. Nat.

1st 24 hrs. after shot

Gas Cu. Ft.

Dry Hole

Abandoned

Date

MAR 16 1938 19

H. D. Hatfield Scout