


Rice KANSAS

Section 13 Township 18 Range 8-W

Well No. #3 J. A. Lewis "A"

Company Continental et al

NORTH Genesee Pool

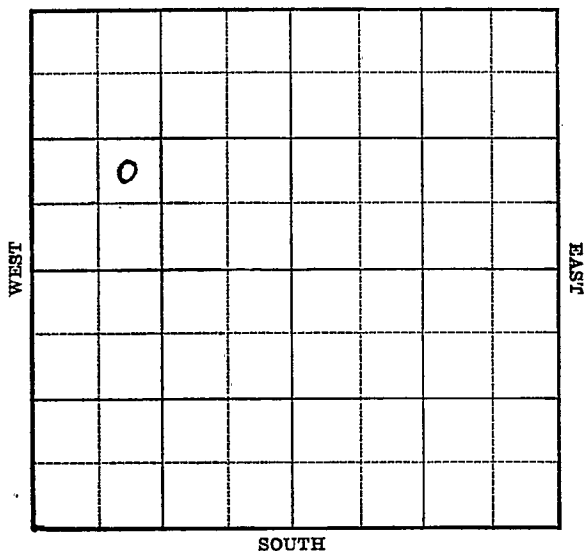

Rice

KANSAS

Map No. 45 Sec. 13 Twp. 18 R. 8WWell No. 3 J. A. Lewis "A"Continental etal

Company

Contractor

FIRST REPORT

NE SW NW

SECTION PLAT

0			

 Ft. from N. Line990 Ft. from S. Line Ft. from E. Line990 Ft. from W. Line

GENESEO POOL

Location Rig up

Drilling and Remarks:

Cellar

RECORD

Cased in., ft.Sand Gas Oil Total Depth

PRODUCTION

1st 24 hrs. Nat. 1st 24 hrs. after shot Gas Cu. Ft.Dry Hole Abandoned

Date

MAY 24 1939 19

S. J. LEWIS

Scout

Rice

KANSAS

Map No. 45 Sec. 13 Twp. 18 R. 8WWell No. 3 J. A. Lewis "A"Continental etal Company

Contractor

COMPLETED

NE SW NW

Ft. from N. Line

990 Ft. from S. Line

Ft. from E. Line

990 Ft. from W. Line

GENESEO POOL

SECTION PLAT

0			

Location _____

Rig up _____

Drilling and Remarks:

*Cr 83263**7" @ 3423**6000 acid**Input 600 ft/hr**per hr**W. J. J.*

RECORD

Cased _____ in., _____ ft.

Sand _____

Gas _____

Oil _____

Total Depth 3677

PRODUCTION

1st 24 hrs. Nat. _____

1st 24 hrs. after shot _____

Gas _____ Cu. Ft.

Dry Hole _____

Abandoned _____

Date

JUN 28 1939

19

S. J. LEWIS

Scout

O. W. D. D

FORM 513 SUNRAY

County Rice Elev. 1745
 Sec. 13 Twp. 18 Rge. 8W
 Company Continental Oil
 FarmName Lewis "A" No. 3

TOPS	DEPTH	LOG	DATUM	Loc. in Sec.
Anb.				NE SW NW OWDD
Tr.				
H.				
Tr.				
Dg.				Geol. <u>O. W. D. D</u> Contr.
BL.				
L.				Pool 0 FIRST REPORT COMPLETE
K.C.				
B.K.C.				
Ce.				
C.				
M.				
M.				
K.				
Mz.				
Me.				
V.				No. 1 Sec. 13 T. 18 R. 8W
S.				
S.				
A.	3263			
R.	3765			
Pe.	3793			
G.				
T.D.				

Date Comm.

OTD 3716 7" @ 3423 DD1304
5" liner @ 3412/250 CO to 14304
Comp. SWD well input 500 bwph

12