
FORM 51 5M 2-38 TPCO. Rice KANSAS

Section 13 Township 18 Range 8-W

Well No. 3 Pickerill

Company Continental et al

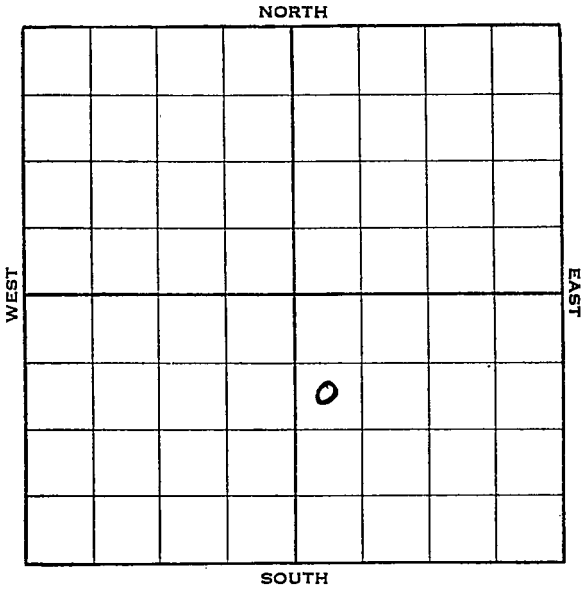

FORM 252-A 5M 1-38 KANSAS Rice

Sec. 13 Twp. 18 R. 8-W

Well No. #3 Pickerill Farm


Continental et al Company

990 Ft. from N. Line

Ft. from S. Line

Ft. from E. Line

330 Ft. from W. Line

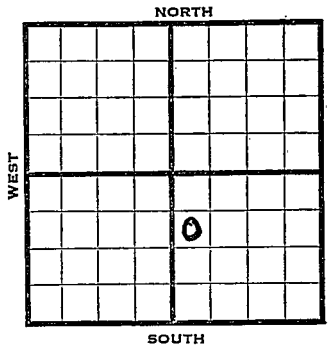

Elev. 1720

1938	REPORT
4/13	Cellar.
4/22	"
4/29	10" @ 219'. Drlg. 2840'.
5/6	Arb. 3211'. 7" @ 3212'.
	T.D. 3218'. 3150' oil.
5/10	7" @ 3212'.
	Arb. 3211'.
	T.D. 3218'.
	Potential 1904 bbls., Nat'l.
	COMPLETED

Form 26—1M Bks.—2-29

Rice KANSAS

Map No. 45 Sec. 13 Twp. 18 R. 8W

Well No. 3 Pickerill

Continental etal Company

Contractor

FIRST REPORT

SW NW SE


990 Ft. from N. Line

_____ Ft. from S. Line

_____ Ft. from E. Line

330 Ft. from W. Line

SECTION PLAT

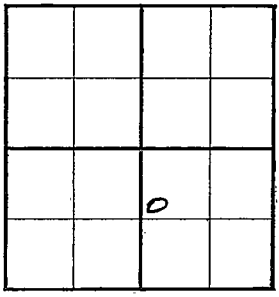

Location _____

Rig up _____

Drilling and Remarks:

Cellar

RECORD

Cased _____ in., _____ ft.

Sand _____

Gas _____

Oil _____

Total Depth _____

PRODUCTION

1st 24 hrs. Nat. _____

1st 24 hrs. after shot _____

Gas _____ Cu. Ft.

Dry Hole _____

Abandoned _____

Date

APR 13 1938 19

H. D. Hatfield Scout

Form 26—1M Bks.—2-29 Rice KANSAS

Map No. 45 Sec. 13 Twp. 18 R. 8W

Well No. 3 Pickerill

Continental Company

Contractor

COMPLETED

SW NW SE


990 Ft. from N. Line

_____ Ft. from S. Line

_____ Ft. from E. Line

330 Ft. from W. Line

SECTION PLAT

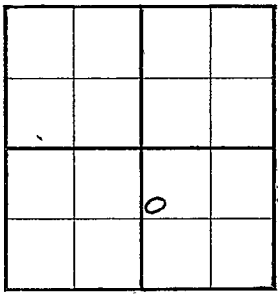

Location _____

Rig up _____

Drilling and Remarks:

PoT 1904

NaT

RECORD

Cased 7 in., 3212 ft.

Sand Arb 3211

Gas _____

Oil _____

Total Depth 3218

PRODUCTION

1st 24 hrs. Nat. _____

1st 24 hrs. after shot _____

Gas _____ Cu. Ft.

Dry Hole _____

Abandoned _____

Date

MAY 10 1938 19____

D. Hatfield Scout