




11003  
Map No. 119 Sec. 32 Twp 25 R. 5

Well No. 24 L. W. C. P. Farm  
Empire Company

NORTH

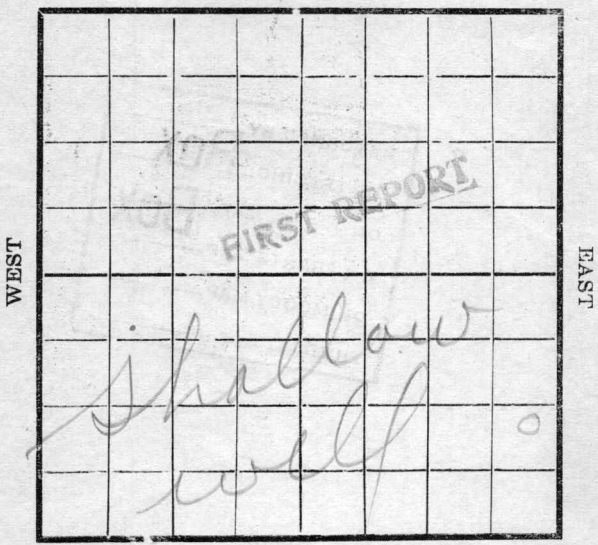

SOUTH

Location -----  
 Rig Up -----  
 Drilling and remarks  
50' N / 850' W  
of #11

**RECORD**

Cased ----- in. ----- Ft.  
 Sand -----  
 Gas -----  
 Oil -----  
 Total Depth -----


**PRODUCTION**

1st 24 hrs. Nat. -----  
 1st 24 hrs. after shot -----  
 Gas ----- Cu. Ft.  
 Dry Hole -----  
 Abandoned -----

Date  
1/5, 1915 S. J. Pyle Scout

Map No. \_\_\_\_\_ Sec. 32 Twp. 25 R. 5  
 Well No. 24 Lister Farm \_\_\_\_\_  
Empire Company \_\_\_\_\_

NORTH

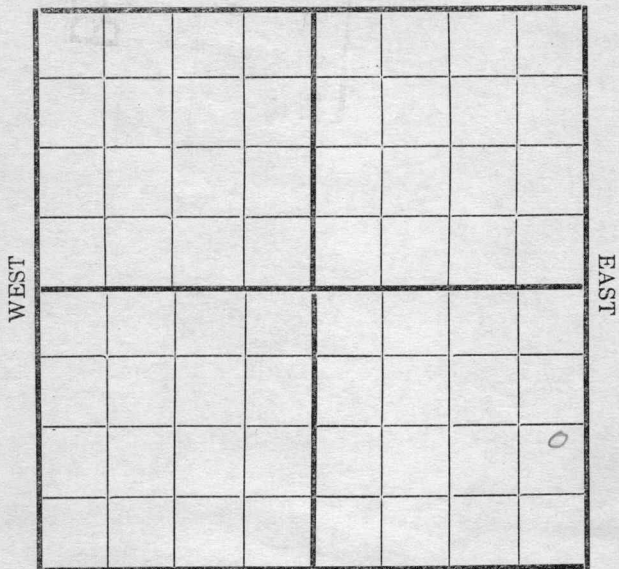

SOUTH

Location \_\_\_\_\_  
 Rig Up \_\_\_\_\_  
 Drilling and remarks \_\_\_\_\_

**RECORD**  
 Cased \_\_\_\_\_ in. \_\_\_\_\_ Ft.  
 Sand \_\_\_\_\_  
 Gas \_\_\_\_\_  
 Oil \_\_\_\_\_  
 Total Depth \_\_\_\_\_


**PRODUCTION**  
 1st 24 hrs. Nat. \_\_\_\_\_  
 1st 24 hrs. after shot \_\_\_\_\_  
 Gas \_\_\_\_\_ Cu. Ft. .  
 Dry Hole \_\_\_\_\_  
 Abandoned \_\_\_\_\_

360'  
50' N 850 W of  
#11

Date 1/11, 1918 Cyle Scout

Map No. \_\_\_\_\_ Sec. 32 Twp. 25 R. 5  
 Well No. 24 Lister Farm \_\_\_\_\_  
Empire Company \_\_\_\_\_

NORTH

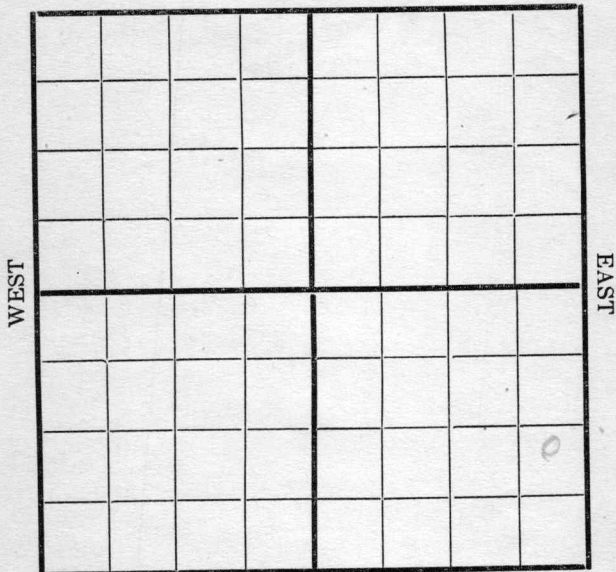

SOUTH

Location \_\_\_\_\_  
 Rig Up \_\_\_\_\_  
 Drilling and remarks \_\_\_\_\_

930'

**RECORD**

Cased \_\_\_\_\_ in. \_\_\_\_\_ Ft.  
 Sand \_\_\_\_\_  
 Gas \_\_\_\_\_  
 Oil \_\_\_\_\_  
 Total Depth \_\_\_\_\_

**PRODUCTION**


1st 24 hrs. Nat. \_\_\_\_\_  
 1st 24 hrs. after shot \_\_\_\_\_  
 Gas \_\_\_\_\_ Cu. Ft.  
 Dry Hole \_\_\_\_\_  
 Abandoned \_\_\_\_\_

Date \_\_\_\_\_

1/25, 1918 Pyle Scout

Map No. \_\_\_\_\_ Sec. 32 Twp. 25 R. 5  
Well No. 24 Lister Farm \_\_\_\_\_  
Empire Company \_\_\_\_\_

NORTH

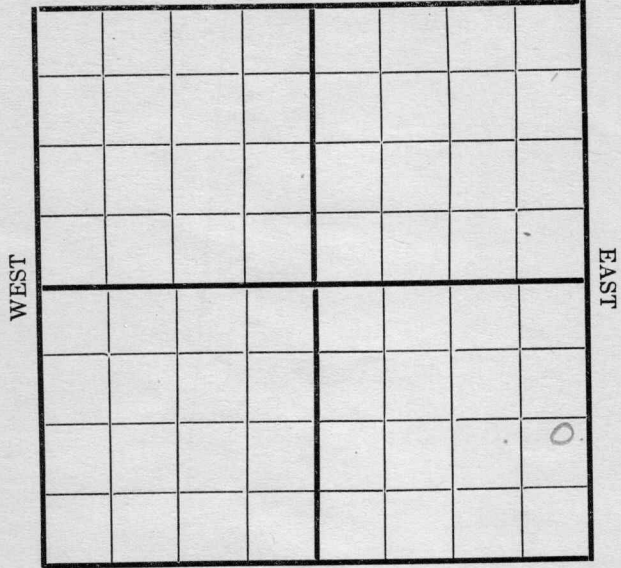

SOUTH

Location \_\_\_\_\_  
 Rig Up \_\_\_\_\_  
 Drilling and remarks \_\_\_\_\_  
 @ 10  
 @  
 700'

**RECORD**

Cased \_\_\_\_\_ in. \_\_\_\_\_ Ft.  
 Sand \_\_\_\_\_  
 Gas 610-625  
 Oil \_\_\_\_\_  
 Total Depth \_\_\_\_\_

**PRODUCTION**


1st 24 hrs. Nat. \_\_\_\_\_  
 1st 24 hrs. after shot \_\_\_\_\_  
 Gas \_\_\_\_\_ Cu. Ft.  
 Dry Hole \_\_\_\_\_  
 Abandoned \_\_\_\_\_

Date 1/17, 1918 \_\_\_\_\_ Pyle Scout

Map No. \_\_\_\_\_ Sec. 32 Twp. 25 R. 5

Well No. 24 Inter Farm \_\_\_\_\_  
Empire Company

NORTH

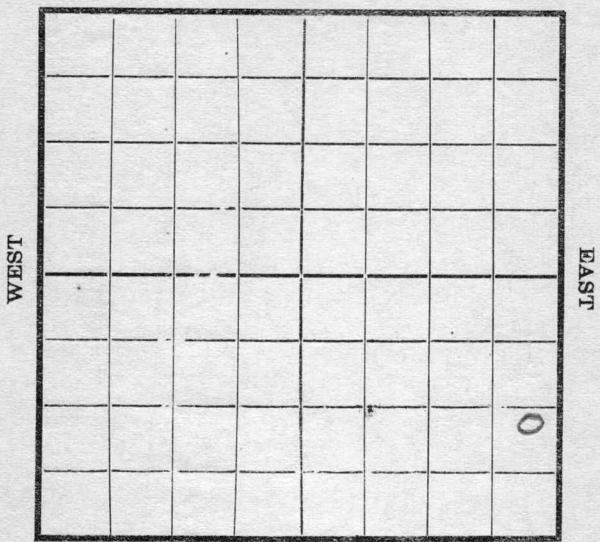

SOUTH

Location \_\_\_\_\_  
 Rig Up \_\_\_\_\_  
 Drilling and remarks

*A. 10*  
*@*  
*930*

**RECORD**

Cased \_\_\_\_\_ in. \_\_\_\_\_ Ft.  
 Sand \_\_\_\_\_  
 Gas \_\_\_\_\_  
 Oil \_\_\_\_\_  
 Total Depth \_\_\_\_\_

**PRODUCTION**

1st 24 hrs. Nat. \_\_\_\_\_  
 1st 24 hrs. after shot \_\_\_\_\_  
 Gas \_\_\_\_\_ Cu. Ft.  
 Dry Hole \_\_\_\_\_  
 Abandoned \_\_\_\_\_


Date \_\_\_\_\_, 1918 \_\_\_\_\_ Scout

*30*

Map No. ----- Sec. 32 Twp. 25 R. 5

Well No. 24 Lister Farm  
Empire Company

NORTH

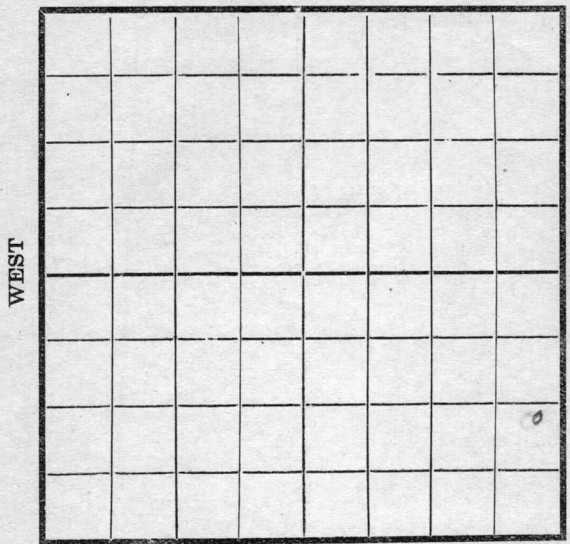

SOUTH

Location -----  
 Rig Up -----  
 Drilling and remarks

*fishing*  
 @  
 930'

**RECORD**

Cased ----- in. ----- Ft.  
 Sand -----  
 Gas -----  
 Oil -----  
 Total Depth -----

**PRODUCTION**

1st 24 hrs. Nat. -----  
 1st 24 hrs. after shot -----  
 Gas ----- Cu. Ft.  
 Dry Hole -----  
 Abandoned -----


Date

4, 1911 Oyle Scout

Map No. \_\_\_\_\_ Sec. 32 Twp. 25 R. 5

Well No. 24 Lister Farm \_\_\_\_\_  
Empire Company

NORTH

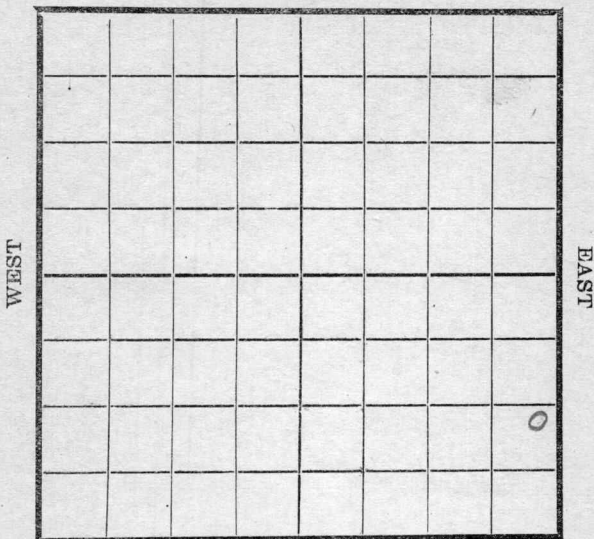

SOUTH

Location \_\_\_\_\_  
 Rig Up \_\_\_\_\_  
 Drilling and remarks

1030

**RECORD**

Cased \_\_\_\_\_ in. \_\_\_\_\_ Ft.  
 Sand \_\_\_\_\_  
 Gas \_\_\_\_\_  
 Oil \_\_\_\_\_  
 Total Depth \_\_\_\_\_

**PRODUCTION**


1st 24 hrs. Nat. \_\_\_\_\_  
 1st 24 hrs. after shot \_\_\_\_\_  
 Gas \_\_\_\_\_ Cu. Ft.  
 Dry Hole \_\_\_\_\_  
 Abandoned \_\_\_\_\_

Date 2/13, 1918 Oyle Scout

Map No. K14 Sec. 32 Twp. 25 R. 5

Well No. 24 Fister Farm  
Empire Company

NORTH

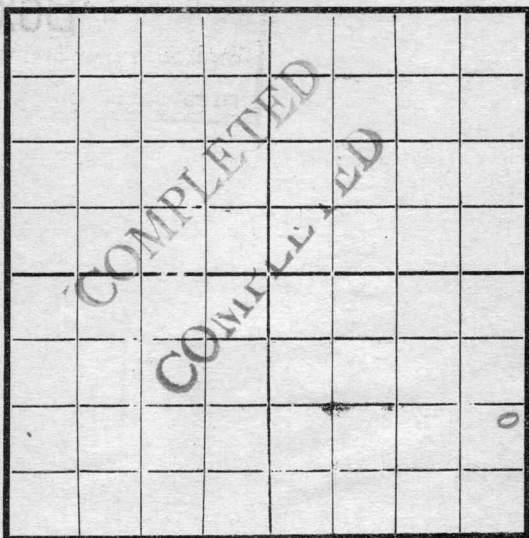

SOUTH

Location -----

Rig Up -----

Drilling and remarks

1,000,000  
Cubic  
ft

**RECORD**

Cased ----- in. ----- Ft.

Sand -----

Gas 610-625-700

Oil -----

Total Depth 1185

**PRODUCTION**

1st 24 hrs. Nat. -----

1st 24 hrs. after shot -----

Gas 1,000,000 Cu. Ft.

Dry Hole -----

Abandoned -----

Date

2/20, 1918 Pyle Scout