

Map No. _____ Sec. 32 Twp. 25 R. 5
Well No. 28 Luster Farm
Empire Company

NORTH

WEST

EAST

SOUTH

Location -----

Drilling Remarks:

Rig Up -----

Drilling Remarks:

RECORD

Cased-----in, -----ft.

Sand -----

Gas -----

Oil_____

Total Depth -----

PRODUCTION

1st 24 hrs. Nat.-----

1st 24 hrs. after shot-----

Gas-----cu. ft

Dry Hole -----

Abandoned -----

Map No. _____ Sec. 32 Twp. 25 R. 5

Well No. 28 Lister Farm
Empire Company


Contractor S.E. Quarter

230 Ft. from N. Line

Ft. from S. Line

Ft. from E. Line

230 Ft. from W. Line

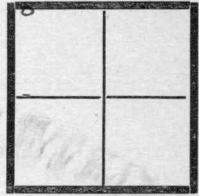

1919
Date

REPORT

11/13 Sand 2430 - 67
3 Bbl


Map No. 1514 Sec. 32 Twp. 25 R. 5

Well No. 28 Lister

Empire Company

Contractor

NORTH

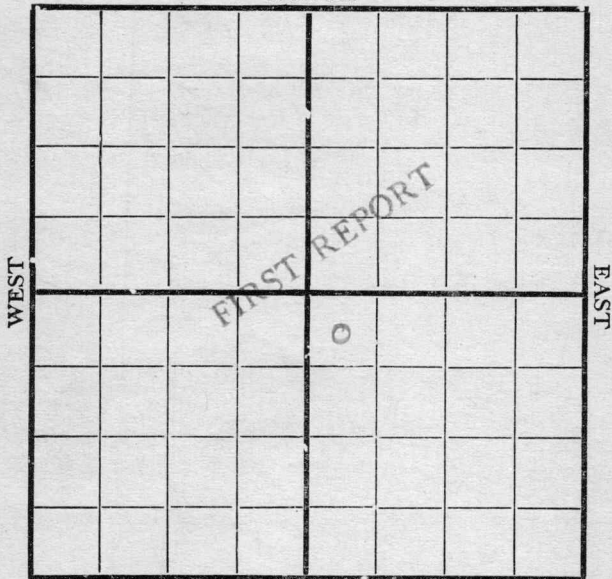

330 N-W SOUTH

Location _____

Rig up _____

Drilling and Remarks:

Imber

RECORD

Cased _____ in., _____ ft.

Sand _____

Gas _____

Oil _____

Total Depth _____

PRODUCTION

1st 24 hrs. Nat. _____

1st 24 hrs. after shot _____

Gas _____ Cu. Ft.

Dry Hole _____

Abandoned _____

Date

7/9 1919 Pyle Scout

Map No. 1514 Sec. 32 Twp. 25 R. 5Well No. 28- ListerEmpire Company


Contractor

SECTION PLAT

330 Ft. from N. Line

Ft. from S. Line

Ft. from E. Line

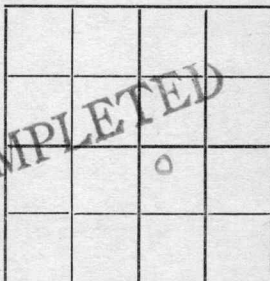330 Ft. from W. Line

Location

Rig up

Drilling and Remarks:

RECORD

Cased _____ in., _____ ft.

Sand 2430 - 2467

Gas _____

Oil _____

Total Depth _____

PRODUCTION

1st 24 hrs. Nat. 3 bbls

1st 24 hrs. after shot _____

Gas _____ Cu. Ft.

Dry Hole _____

Abandoned _____

Date

11/13 1919 Pyle Scout