


Map No. _____ Sec. 32 Twp. 75 R. 5

Well No. 17 Moles Farm _____

Empire Company _____

NORTH

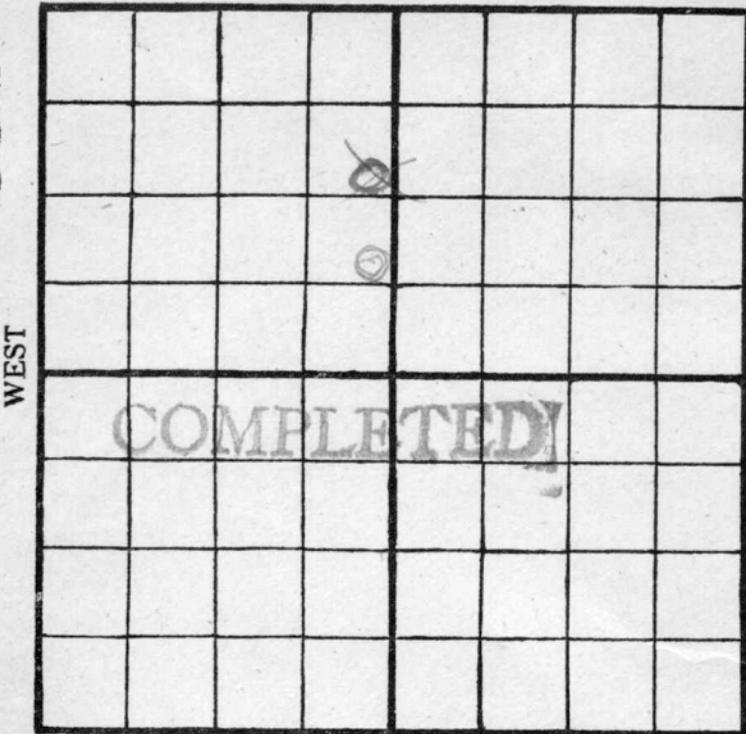

WEST

EAST

SOUTH

Location _____

Rig Up _____

Drilling Remarks:

Drilling Remarks:

55 Blies -

600-645.

2/28/18

RECORD

PRODUCTION

Cased _____ in. _____ ft.

1st 24 hrs. Nat. _____

Sand _____

1st 24 hrs. after shot _____

Gas _____

Gas _____ cu. ft.

Oil _____

Dry Hole _____


Total Depth _____

Abandoned _____

Map No. 1043 K14 Sec. 32 Twp. 25 R. 5

Well No. 17 Moler Farm
Empire Company

NORTH

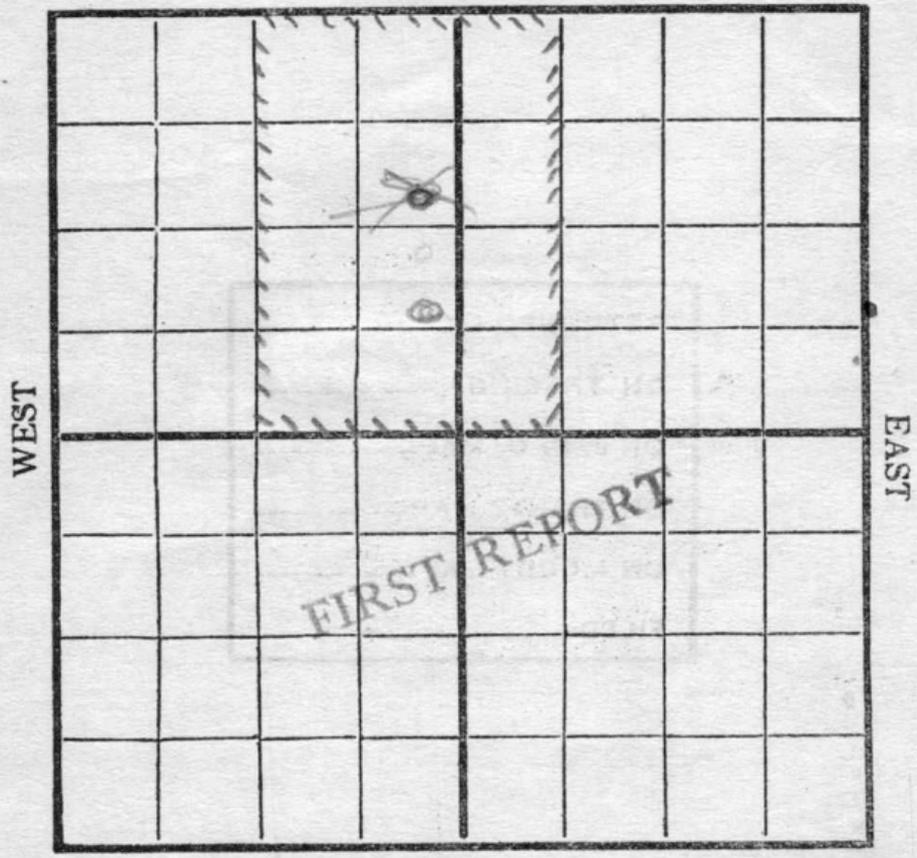

SOUTH

FIRST REPORT

Location ✓

Rig Up

Drilling and remarks

792 N
264 W

RECORD

Cased _____ in. _____ Ft.
 Sand _____
 Gas _____
 Oil _____
 Total Depth _____

PRODUCTION

1st 24 hrs. Nat. _____
 1st 24 hrs. after shot _____
 Gas _____ Cu. Ft.
 Dry Hole _____
 Abandoned _____


Date

4/24

1918

Oyle Scout

Map No. _____ Sec. 32 Twp. 25 R. 5
 Well No. 17 noles Farm _____
Empire Company
 NORTH

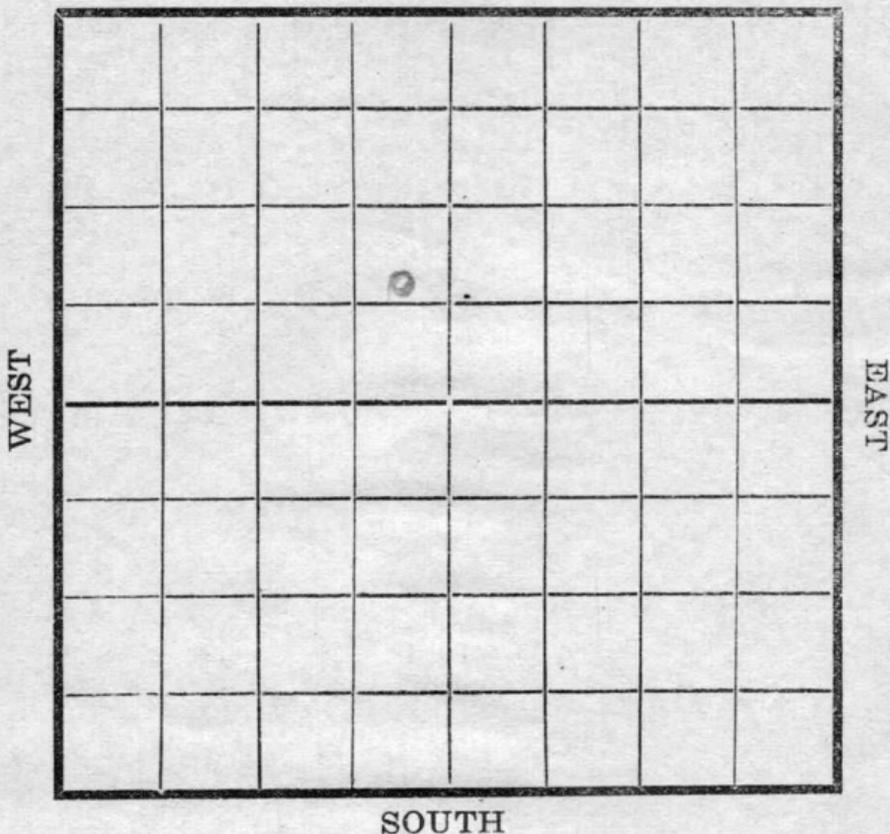


Location _____ Rig Up _____ Drilling and remarks <i>fishing for</i> <i>tools @</i> <i>490'</i>	<p style="text-align: center;">RECORD</p> Cased _____ in. _____ Ft. Sand _____ Gas _____ Oil _____ Total Depth _____ <hr/> <p style="text-align: center;">PRODUCTION</p> 1st 24 hrs. Nat. _____ 1st 24 hrs. after shot _____ Gas _____ Cu. Ft. Dry Hole _____ Abandoned _____
---	--

Date 5/2, 1918 Oyle Scout

Map No. _____ Sec. 32 Twp. 25-5 R. 5

Well No. 17 Moler Farm _____
Empire Company _____

NORTH

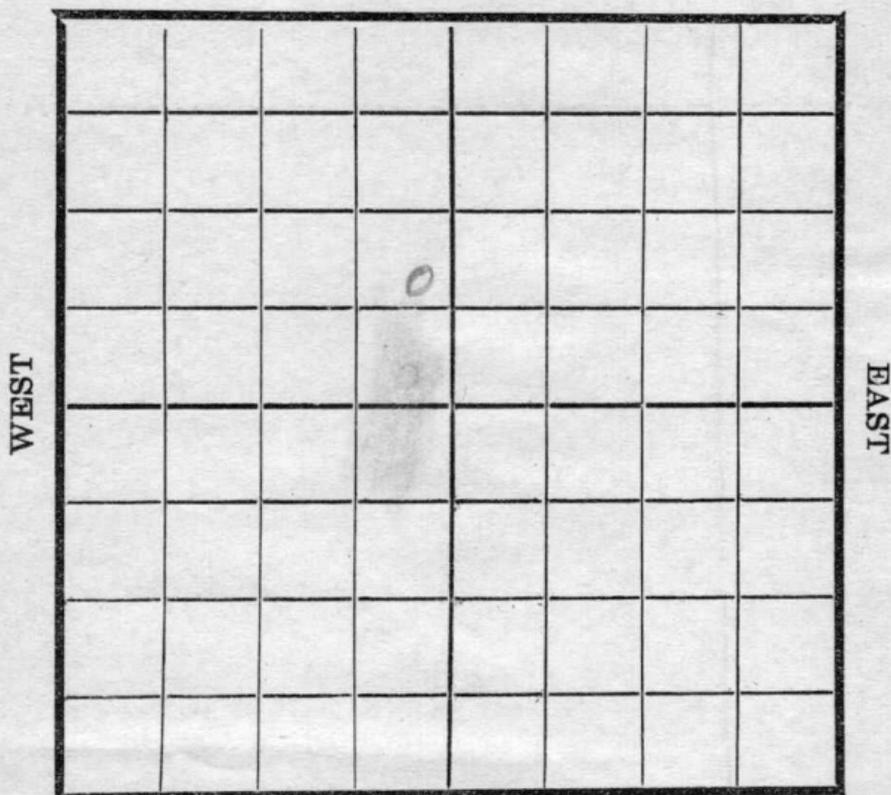

SOUTH

Location _____
 Rig Up _____
 Drilling and remarks _____

*fishing
 tools @
 490'*

RECORD

Cased _____ in. _____ Ft.
 Sand _____
 Gas _____
 Oil _____
 Total Depth _____

PRODUCTION

1st 24 hrs. Nat. _____
 1st 24 hrs. after shot _____
 Gas _____ Cu. Ft.
 Dry Hole _____
 Abandoned _____

Date

3/8, 1915 W. J. Oyle Scout


Map No. _____ Sec. 32 Twp. 25 R. 5

Well No. 17 Moler

Empire Company

Contractor _____

NORTH

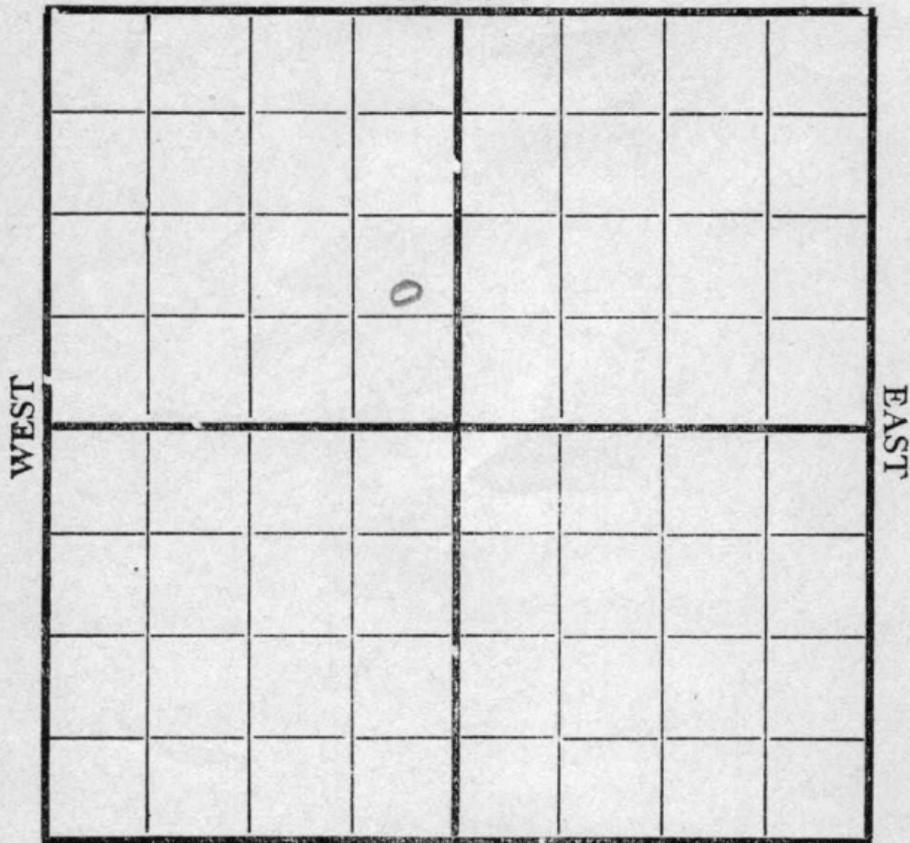

SOUTH

Location _____

Rig up _____

Drilling and Remarks:

501

RECORD

Cased _____ in., _____ ft.

Sand _____

Gas _____

Oil _____

Total Depth _____

PRODUCTION

1st 24 hrs. Nat. _____

1st 24 hrs. after shot _____

Gas _____ Cu. Ft.

Dry Hole _____

Abandoned _____

Date

5/21 1918 Oyler Scout


1003 K 14 Map No. Sec. 32 Twp. 25 R. 5

Well No. 17 Moler

Empire Company

Company Tools Contractor

NORTH

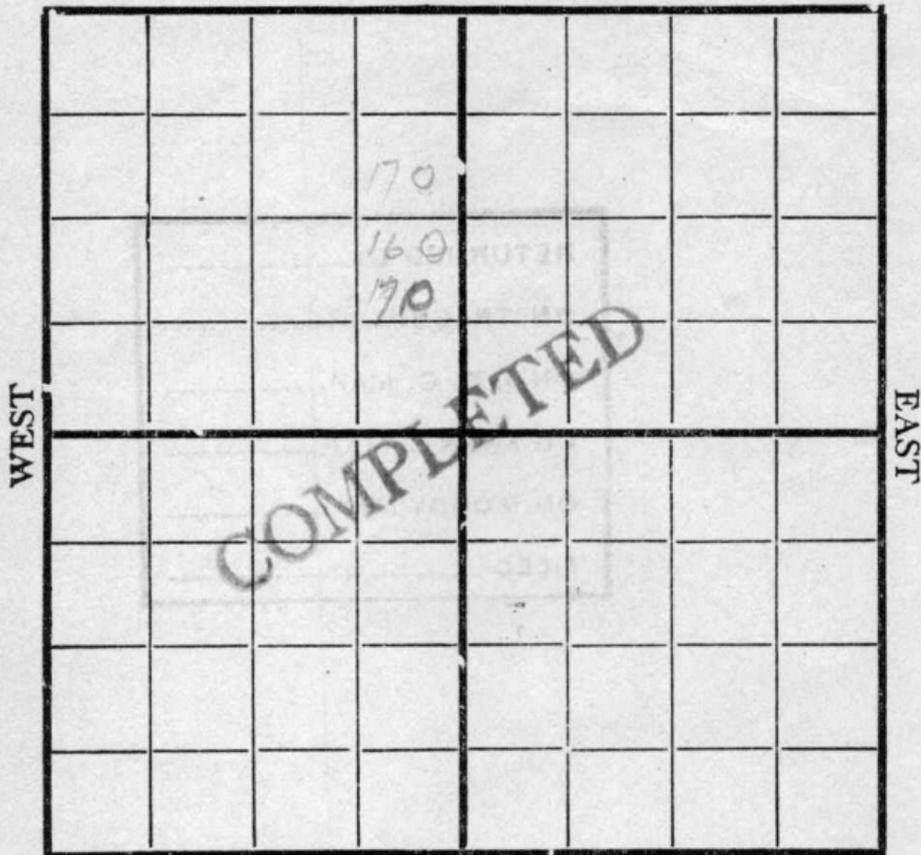

SOUTH

Location -----

Rig up -----

Drilling and Remarks:

RECORD

Cased ----- in., ----- ft.

Sand 620-645

Gas -----

Oil -----

Total Depth -----

PRODUCTION

1st 24 hrs. Nat. 55 bbl

1st 24 hrs. after shot -----

Gas ----- Cu. Ft.

Dry Hole -----

Abandoned -----

Date

5/28 1918 Dyb Scout