

State Kansas County Brahm

Company Colorado Oil & Gas Corp Well No. 1


Farm (Walker) Dietz "B"

Survey _____

Block No. _____ Sec. 8 Twp. 10^s Range 23^w

Co-Ord. C.P. 3650 S.P. 3750 Elev. 2415 KB

the new line Reg #1 24120F

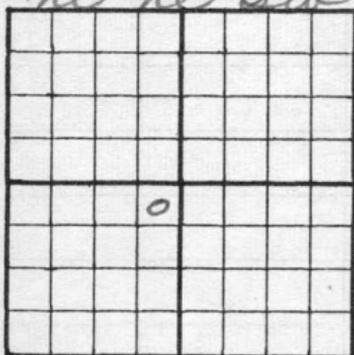

100% - Colo. Oil & Gas Corp

NOTE: Show Sketch of Lease and Well Location in Above Space

Ft. from N. Line 2310 Ft. from S. Line _____

2310 Ft. from W. Line _____ Ft. from E. Line _____

Date	Depth	
		<u>Spd 7-14-55</u>
<u>7-14</u>		<u>m. o. R. J.</u>
<u>7-15</u>		<u>8 5/8" @ 199 w/150 ad cens, 2 gel</u> <u>2 cc P. D. 11 pm 7-14. Hoc</u>
<u>7-16</u>	<u>1332</u>	<u>Only</u>
	<u>2018</u>	<u>anhydrite (+505)</u>
<u>7-17</u>	<u>2570</u>	<u>"</u>
<u>7-18</u>	<u>3153</u>	<u>" (1/2" off 2858)</u>
<u>7-19</u>	<u>3544</u>	<u>"</u>
<u>7-20</u>	<u>3754</u>	<u>Lensing (-1339)</u>
	<u>3824</u>	<u>Only (3/4" off 3722)</u>

