


Map No. _____ Sec. 31 Twp. 25 R. 5

Well No. 45 Robinson Farm
Empire Company

NORTH

WEST

EAST

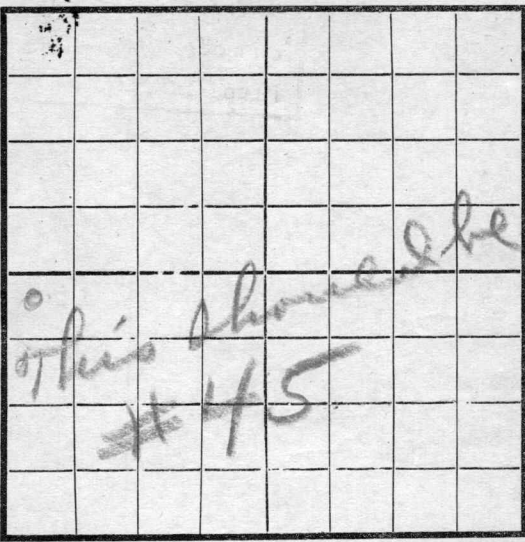

SOUTH

Location ✓
 Rig Up ✓
 Drilling and remarks

RECORD

Cased _____ in. _____ Ft.
 Sand _____
 Gas _____
 Oil _____
 Total Depth _____

PRODUCTION

1st 24 hrs. Nat. _____
 1st 24 hrs. after shot _____
 Gas _____ Cu. Ft.
 Dry Hole _____
 Abandoned _____


FIRST REPORT

Date 9/26, 1917 Condy Scout

Map No. ¹⁰⁰³ R/4 Sec. 31 Twp. 25 R. 5

Well No. 45 Robinson Farm
Engine Company

NORTH

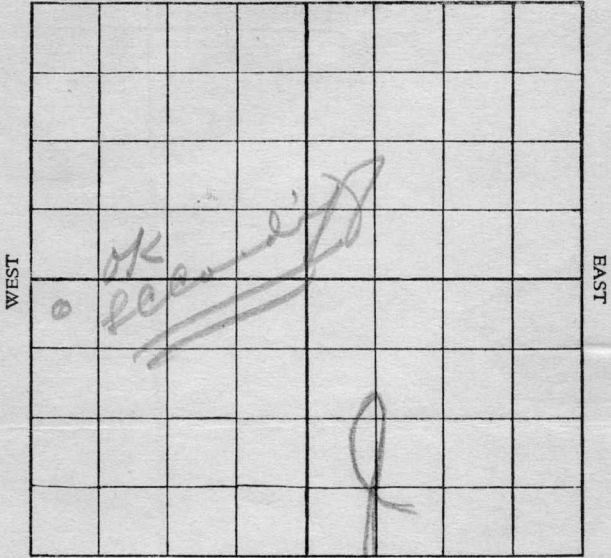

SOUTH

Location _____

Rig up _____

Drilling and remarks:

FIRST REPORT

RECORD

Cased _____ in. _____ Ft.

Sand _____

Gas _____

Oil _____

Total Depth _____

PRODUCTION

1st 24 hrs. Nat. _____

1st 24 hrs. after shot _____

Gas _____ Cu. Ft.

Dry Hole _____

Abandoned _____

Date

10/9, 1912, Robinson Scout


Map No. _____ Sec. 31 Twp. 25 R. 5

Well No. _____ Farm _____
 _____ Company _____

NORTH

WEST

EAST

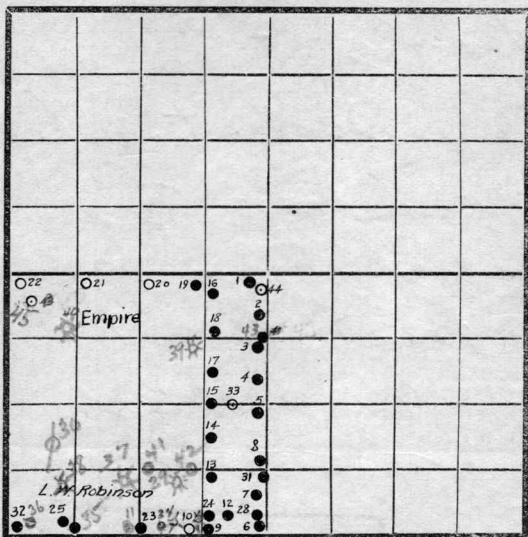

SOUTH

Location _____
 Rig Up _____
 Drilling and remarks _____

RECORD

Cased _____ in. _____ Ft.
 Sand _____
 Gas _____
 Oil _____
 Total Depth _____

PRODUCTION

1st 24 hrs. Nat. _____
 1st 24 hrs. after shot _____
 Gas _____ Cu. Ft.
 Dry Hole _____
 Abandoned _____

Date _____

_____, 191____ Scout _____

Our map shows a
 #43 Rig up at your
 #45 location as on
 this ticket. Please
 check up this.
 Lease and give
 correct locations
 of all wells.

RETURNED BY	_____
ON TRACING	<i>Box</i>
ON J. S. C. MAP	_____
ON FRANTZ MAP	<i>Person</i>
ON MOODY MAP	_____
FILED	_____


PRODUCTION
 1st 24 hrs. Nat.
 1st 24 hrs. after shot
 Gas
 Dry Hole
 Abandoned

Date

Map No. _____ Sec. 31 Twp. 25 R. 5

Well No. 45 Robinson Farm _____
Empire Company

NORTH

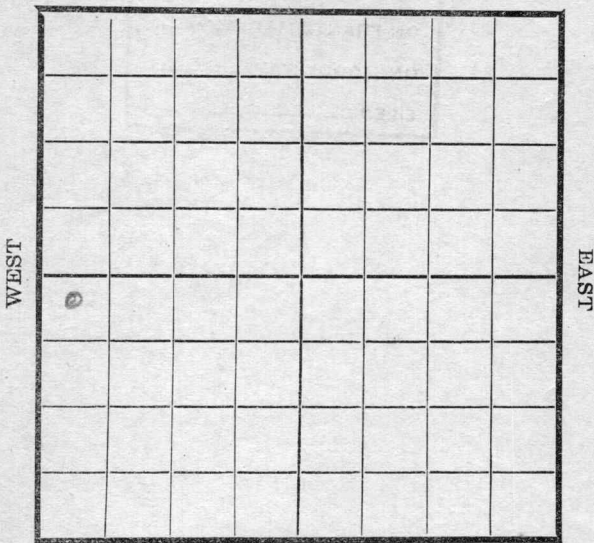

SOUTH

Location _____
 Rig Up _____
 Drilling and remarks _____

RECORD

Cased _____ in. _____ Ft.
 Sand _____
 Gas _____
 Oil _____
 Total Depth _____

PRODUCTION

1st 24 hrs. Nat. _____
 1st 24 hrs. after shot _____
 Gas _____ 0 Cu. Ft.
 Dry Hole _____
 Abandoned _____


Date

11/3, 1917 Pyle Scout

Map No. _____ Sec. 31 Twp. 25 R. 5

Well No. 45 Robinson Farm
Empire Company

NORTH

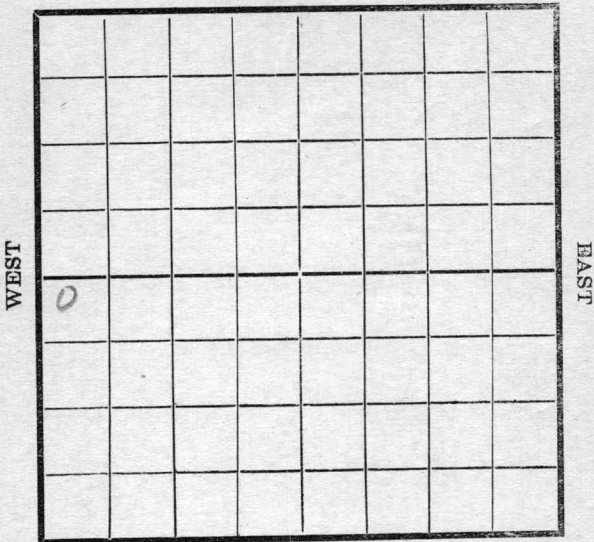

SOUTH

Location _____

Rig Up _____

Drilling and remarks _____

RECORD

Cased _____ in. _____ Ft.

Sand _____

Gas _____

Oil _____

Total Depth _____

PRODUCTION

1st 24 hrs. Nat. _____

1st 24 hrs. after shot _____

Gas _____ Cu. Ft.

Dry Hole _____

Abandoned _____

Date

11/7, 1917 Pyle Scout


Map No. ----- Sec. 31 Twp. 25 R. 5

Well No. 45 Robinson Farm
Empire Company

NORTH

WEST

EAST

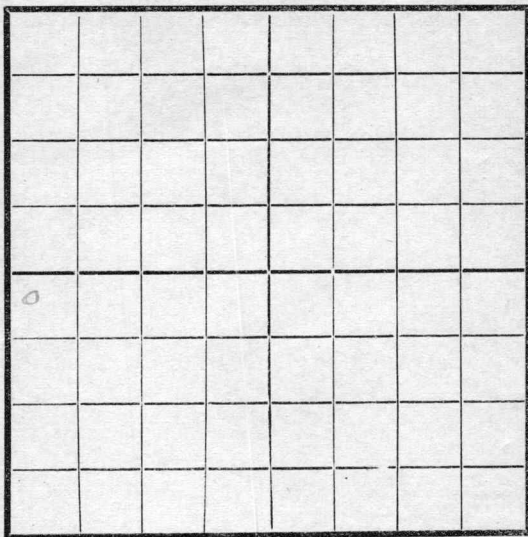

SOUTH

Location -----

Rig Up -----

Drilling and remarks

180'

RECORD

Cased ----- in. ----- Ft.

Sand -----

Gas -----

Oil -----

Total Depth -----

PRODUCTION

1st 24 hrs. Nat. -----

1st 24 hrs. after shot -----

Gas ----- Cu. Ft.

Dry Hole -----

Abandoned -----

Date

11/14, 1917

Gyle


Scout

Map No. _____ Sec. 31 Twp. 25 R. 5

Well No. 45 Robinson Farm _____

_____ Company

NORTH

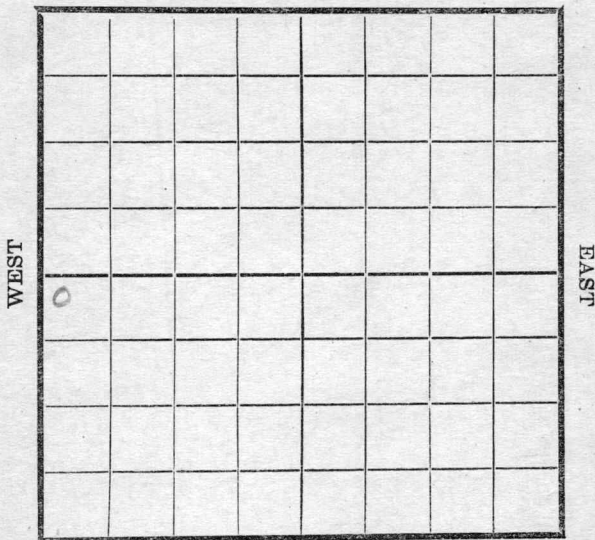

SOUTH

Location _____

Rig Up _____

Drilling and remarks

780'

RECORD

Cased _____ in. _____ Ft.

Sand _____

Gas _____

Oil _____

Total Depth _____

PRODUCTION

1st 24 hrs. Nat. _____

1st 24 hrs. after shot _____

Gas _____ Cu. Ft.

Dry Hole _____

Abandoned _____

Date


11/21, 1917

Payle Scout

Map No. _____ Sec. 31 Twp. 25 R. 5

Well No. 45 Robinson Farm _____
Empire Company

NORTH

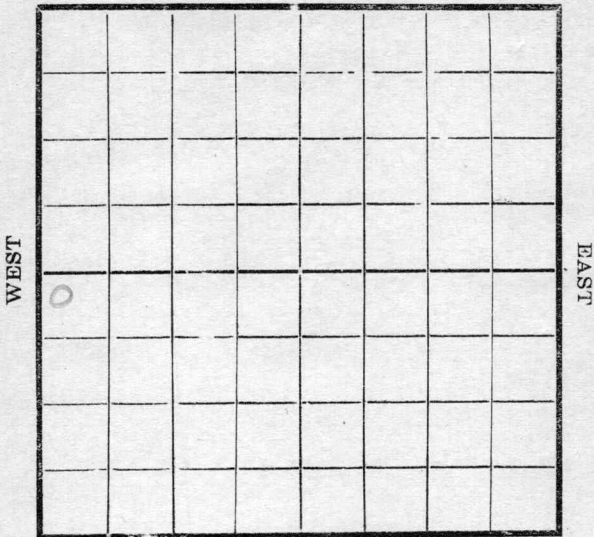


SOUTH

<p>Location _____</p> <p>Rig Up _____</p> <p>Drilling and remarks</p> <p><u>1710'</u></p>	<p style="text-align: center;">RECORD</p> <p>Cased _____ in. _____ Ft.</p> <p>Sand _____</p> <p>Gas _____</p> <p>Oil _____</p> <p>Total Depth _____</p> <hr/> <p style="text-align: center;">PRODUCTION</p> <p>1st 24 hrs. Nat. _____</p> <p>1st 24 hrs. after shot _____</p> <p>Gas _____ Cu. Ft.</p> <p>Dry Hole _____</p> <p>Abandoned _____</p>
---	---

Date 12/17, 1917 Pyle Scout

Map No. _____ Sec. 31 Twp. 25 R. 5
Well No. 45 Robinson Farm
Empire Company

NORTH

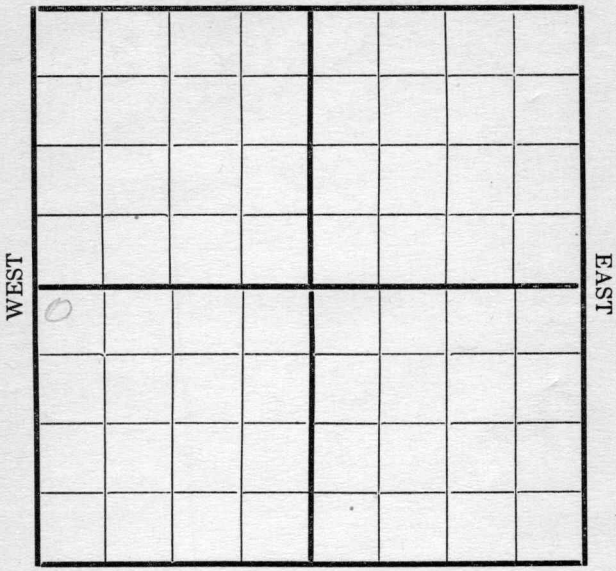

SOUTH

Location _____
Rig Up _____
Drilling and remarks

2100'

RECORD

Cased _____ in. _____ Ft.
Sand _____
Gas _____
Oil _____
Total Depth _____


PRODUCTION

1st 24 hrs. Nat. _____
1st 24 hrs. after shot _____
Gas _____ Cu. Ft.
Dry Hole _____
Abandoned _____

Date 1/11, 1918 Pyle Scout

Map No. _____ Sec. 31 Twp. 25 R. 5
Well No. 45 Robinson Farm
Empire Company

NORTH

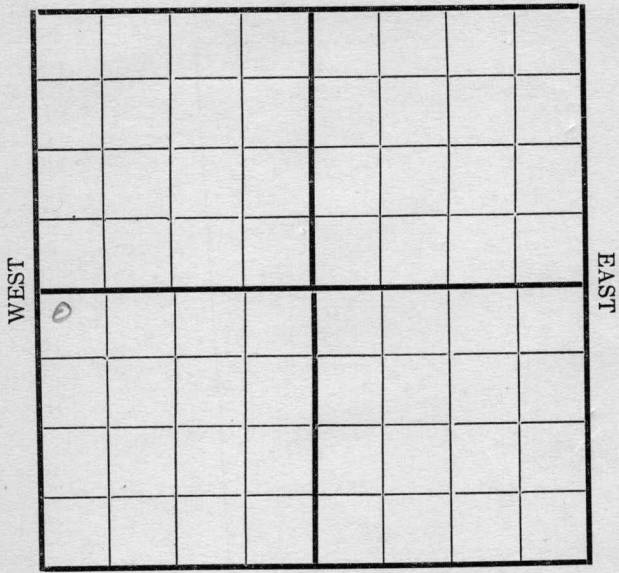

SOUTH

Location _____
Rig Up _____
Drilling and remarks

Handwritten notes:
D 10
@
2245'

RECORD

Cased _____ in. _____ Ft.
Sand _____
Gas _____
Oil _____
Total Depth _____

PRODUCTION


1st 24 hrs. Nat. _____
1st 24 hrs. after shot _____
Gas _____ Cu. Ft.
Dry Hole _____
Abandoned _____

Date 1/17, 1918 8 Cyle Scout

Map No. _____ Sec. 31 Twp. 25 R. 5

Well No. 4/5 Robinson Farm _____
Empire Company _____

NORTH

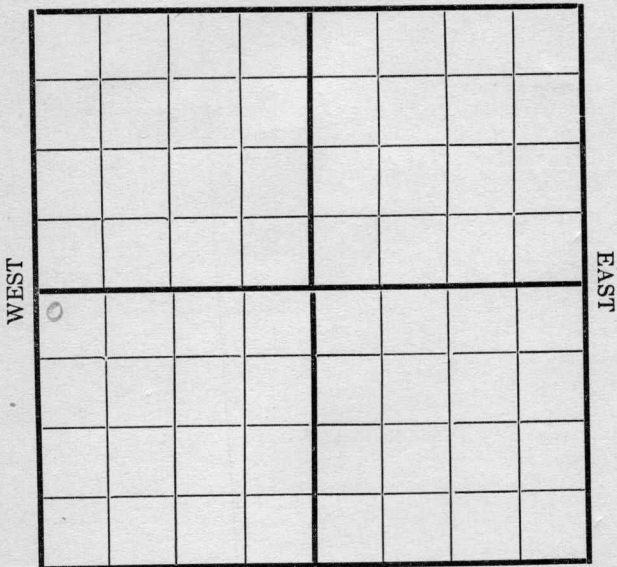

SOUTH

Location _____
Rig Up _____
Drilling and remarks

*cleaning out
@
2345'*

RECORD

Cased _____ in. _____ Ft.
Sand _____
Gas _____
Oil _____
Total Depth _____

PRODUCTION

1st 24 hrs. Nat. _____
1st 24 hrs. after shot _____
Gas _____ Cu. Ft.
Dry Hole _____
Abandoned _____

Date


1/25, 1918

Opel Scout

Map No. _____ Sec. 31 Twp. 25 R. 5

Well No. 45 Robinson Farm _____
Empire Company

NORTH

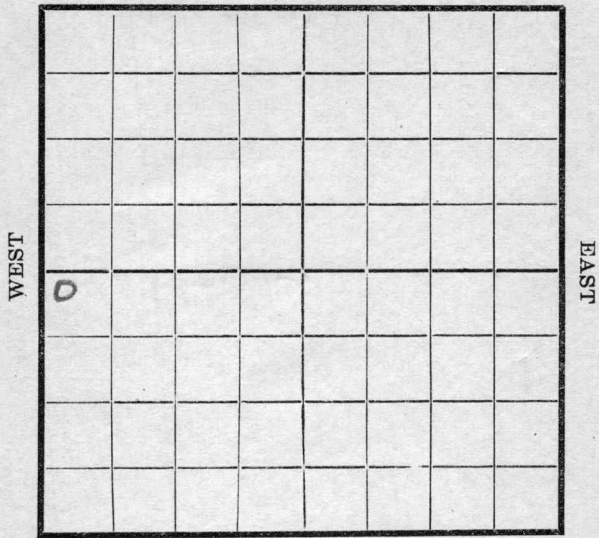

SOUTH

Location _____
 Rig Up _____
 Drilling and remarks

*cleaning
 out
 2345'*

RECORD

Cased _____ in. _____ Ft.
 Sand _____
 Gas _____
 Oil _____
 Total Depth _____


PRODUCTION

1st 24 hrs. Nat. _____
 1st 24 hrs. after shot _____
 Gas _____ Cu. Ft.
 Dry Hole _____
 Abandoned _____

Date _____
1/30, 1918 Pyh Scout

Map No. _____ Sec. 31 Twp. 25 R. 5
Well No. 45 Robinson Farm
Empire Company

NORTH

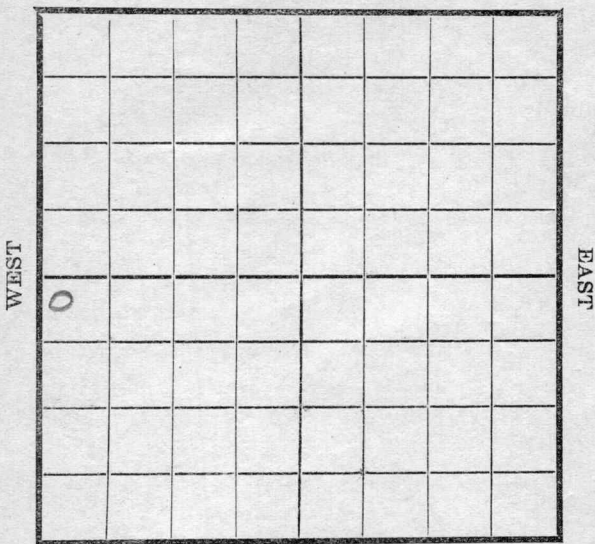

SOUTH

Location _____
Rig Up _____
Drilling and remarks

D.D.
@
2345

RECORD

Cased _____ in. _____ Ft.
Sand _____
Gas _____
Oil _____
Total Depth _____

PRODUCTION

1st 24 hrs. Nat. _____
1st 24 hrs. after shot _____
Gas _____ Cu. Ft.
Dry Hole _____
Abandoned _____

Date


2/13, 1918 *Pyb* Scout

Map No. ----- Sec. 31 Twp. 25 R. 5

Well No. 45 Robinson Farm
Empire Company

NORTH

WEST

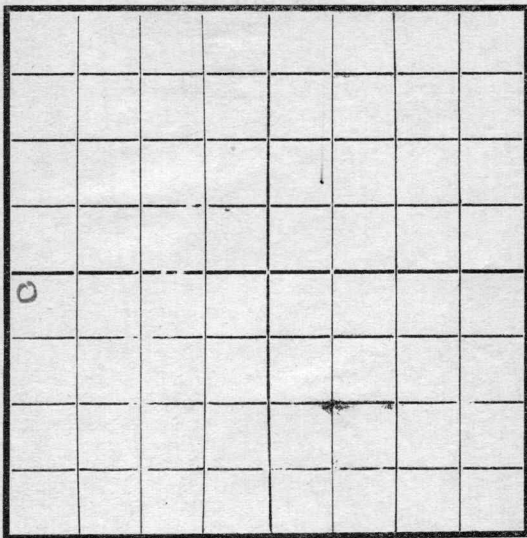

EAST

SOUTH

Location -----
Rig Up -----
Drilling and remarks

DD
@
2345

RECORD

Cased ----- in. ----- Ft.
Sand -----
Gas -----
Oil -----
Total Depth -----

PRODUCTION

1st 24 hrs. Nat. -----
1st 24 hrs. after shot -----
Gas ----- Cu. Ft.
Dry Hole -----
Abandoned -----

Date

2/20, 1918 Lyle Scout


Map No. _____ Sec. 31 Twp. 25 R. 5

Well No. 45 Robinson Farm _____
Empire Company

NORTH

WEST

EAST

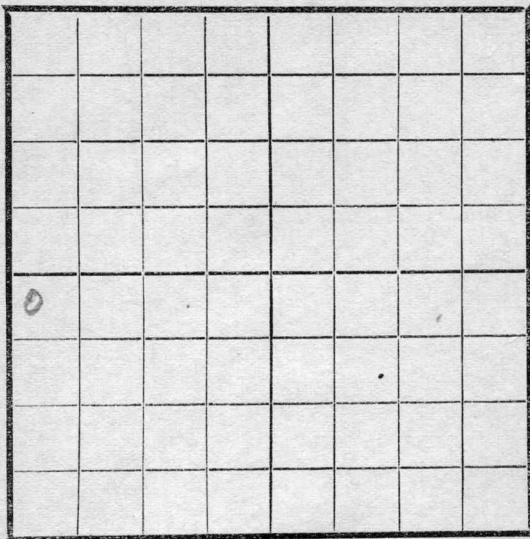

SOUTH

Location _____

Rig Up _____

Drilling and remarks

2448'

Heiler Bro

RECORD

Cased _____ in. _____ Ft.

Sand _____

Gas _____

Oil _____

Total Depth _____

PRODUCTION

1st 24 hrs. Nat. _____

1st 24 hrs. after shot _____

Gas _____ Cu. Ft.

Dry Hole _____

Abandoned _____

Date

2/27, 1918

Oyle Scout

Map No. _____ Sec. 31 Twp. 25 R. 5

Well No. 45 Robinson Farm

Empire Company

NORTH

WEST

EAST



SOUTH

Location _____

Rig Up _____

Drilling and remarks

RECORD

Cased _____ in _____ Ft.

Sand 2444-2448

Gas _____

Oil 115 bbls.

Total Depth _____

PRODUCTION

1st 24 hrs. Nat. _____

1st 24 hrs. after shot _____

Gas _____ Cu. Ft.

Dry Hole _____

Abandoned _____


Date

3/9, 1918

Cyle Scout

_____ Scout

Map No. 003114 Sec. 31 Twp. 25 R. 5
 Well No. 45-43 Robinson
 _____ Company
 _____ Contractor

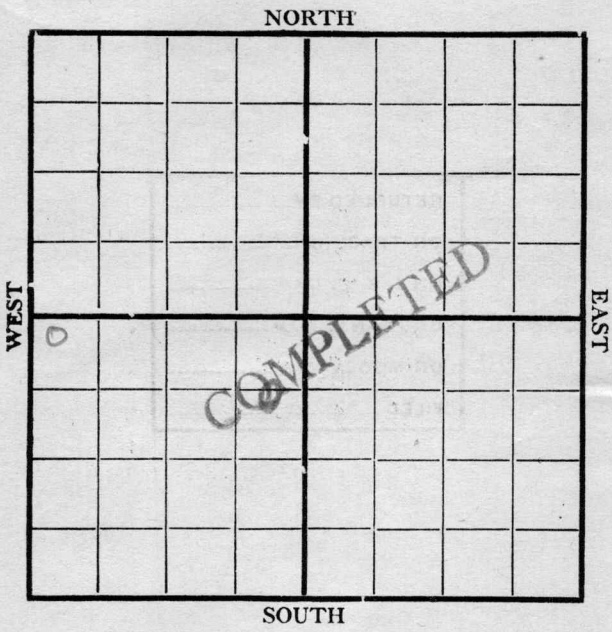

Location _____
 Rig up _____
 Drilling and Remarks:
*This is #45
 instead of
 #43*

RECORD

Cased _____ in., _____ ft.
 Sand 2443 - 2446
 Gas _____
 Oil _____
 Total Depth _____

PRODUCTION

1st 24 hrs. Nat. 60 bbls
 1st 24 hrs. after shot _____
 Gas _____ Cu. Ft.
 Dry Hole _____
 Abandoned _____

Date 7/8 1918 J. L. Pyle Scout