


Map No. K14 Sec. 31 Twp. 25 R. 5

Well No. 48 Robinson

Empire Company

Contractor

NORTH

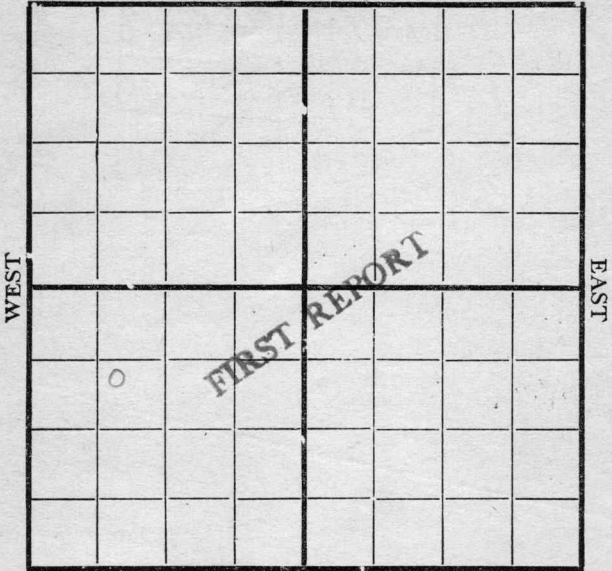

735 N-W SOUTH

Location _____

Rig up _____

Drilling and Remarks:

RECORD

Cased _____ in., _____ ft.

Sand _____

Gas _____

Oil _____

Total Depth _____

PRODUCTION

1st 24 hrs. Nat. _____

1st 24 hrs. after shot _____

Gas _____ Cu. Ft.

Dry Hole _____

Abandoned _____

Date

5/6 1919 Pyle Scout


Map No. K14 Sec. 31 Twp. 25 R. 5

Well No. 48 Robinson

Empire Company

Contractor

NORTH

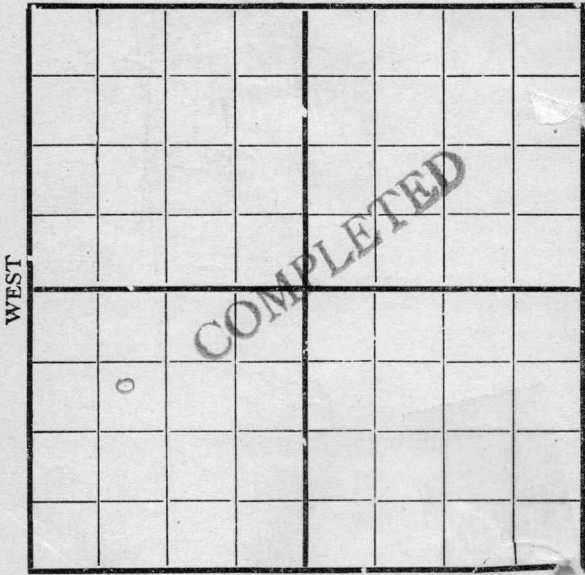

735 N-W SOUTH

Location -----

Rig up -----

Drilling and Remarks:

RECORD

Cased ----- in., ----- ft.

Sand 2482-2484

Gas -----

Oil -----

Total Depth -----

PRODUCTION

1st 24 hrs. Nat. 200 bbls

1st 24 hrs. after shot -----

Gas ----- Cu. Ft.

Dry Hole -----

Abandoned -----

Date

8/1 1919 Pyle Scout