


Section 13 Township 18 Range 8-W

Well Number 5 - Nickel

Company Continental et al

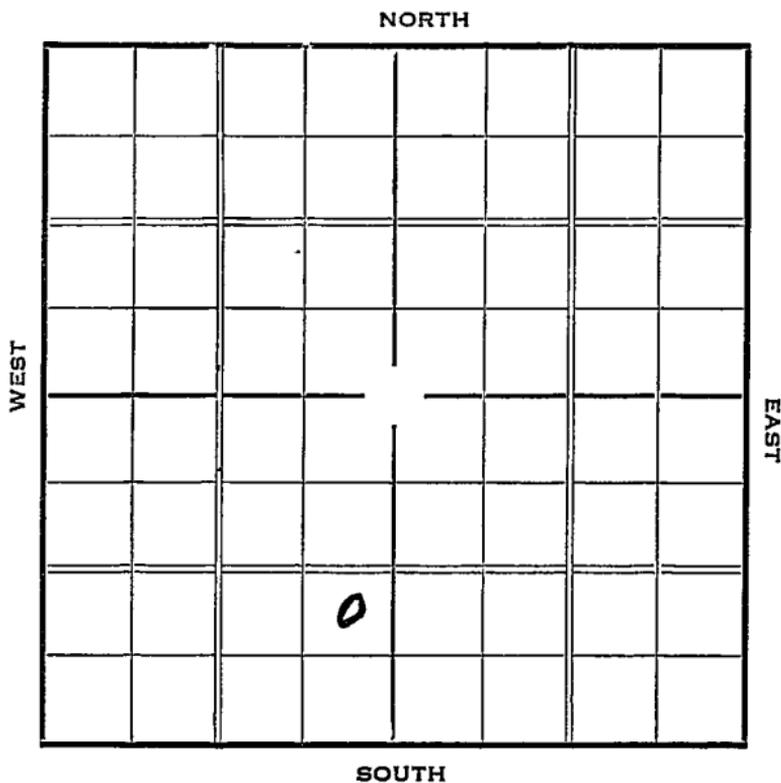

Sec. 13 Twp. 18 R. 8-W

Well No. #5 Nickel Farm

Continental et al Company


 Ft. from N. Line

990 Ft. from S. Line

330 Ft. from E. Line

 Ft. from W. Line

Elev. 1726

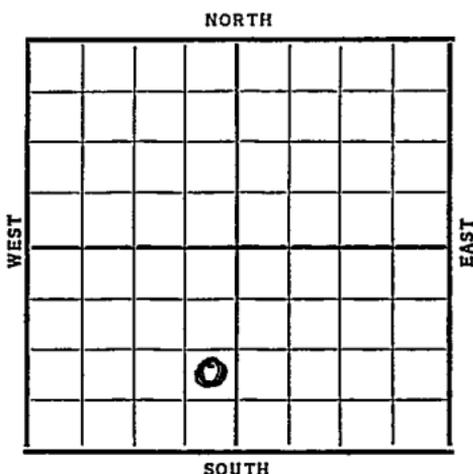

Date	REPORT
1937	
7/14	Cellar
7/23	B. R.
7/30	13" @ 200'. WOG.
8/6	T.D. 1512'. Cementing bad hole.
8/13	Drlg. 1790'.
8/20	Fsg. 3275'.
8/28	Sil. 3225-28' T.D.
	7" @ 3226'. RUST.
9/1	7" @ 3226'.
	Sil. 3225'.
	T.D. 3228'.
	2700' oil.
	Pump 209 bbls. 4 hrs &
	179 bbls. 4 hrs.
	Pot. 1073 bbls.
	COMPLETED

Rice **KANSAS**Map No. _____ Sec. 13 Twp. 18 R. 8^WWell No. 5 - NickelContinental etal Company_____
Contractor**FIRST REPORT**

_____ Ft. from N. Line

990 Ft. from S. Line330 Ft. from E. Line

_____ Ft. from W. Line

SECTION PLAT

	0		

Location _____

Rig up _____

Drilling and Remarks:

Cellar**RECORD**

Cased _____ in., _____ ft.

Sand _____

Gas _____

Oil _____

Total Depth _____

PRODUCTION

1st 24 hrs. Nat. _____

1st 24 hrs. after shot _____

Gas _____ Cu. Ft.

Dry Hole _____

Abandoned _____

Date

JUL 14 1937H. D. Hatfield Scout

Rice KANSAS

Map No. 45 Sec. 13 Twp. 18 R. 8^WWell No. 5-Nickel
Continental etal Company

Contractor

COMPLETED**SECTION PLAT**

	0		

 Ft. from N. Line990 Ft. from S. Line330 Ft. from E. Line Ft. from W. LineLocation Rig up

Drilling and Remarks:

2700' oilP. - 209/4 + 179/4POT - 1073**RECORD**Cased 7 in., 3226 ft.Sand 511 3225Gas Oil Total Depth 3226**PRODUCTION**1st 24 hrs. Nat. 1st 24 hrs. after shot Gas Cu. Ft.Dry Hole Abandoned

Date

SEP 1 1937 19H. D. Hatfield Scout