

State Kansas County Harpur

Company Russell Cobb, Jr., Inc. Well No. 1


Farm C. D. Williams Ranch

Survey \_\_\_\_\_

Block No. \_\_\_\_\_ Sec. 9 Twp. 35<sup>s</sup> Range 5<sup>w</sup>

Co-Ord. CP 3100 S.P. 3700 Elev. 1222' <sup>5-27</sup> Gr

nw nw se Rig # 2 1230 D.F.  
1233 R.B.

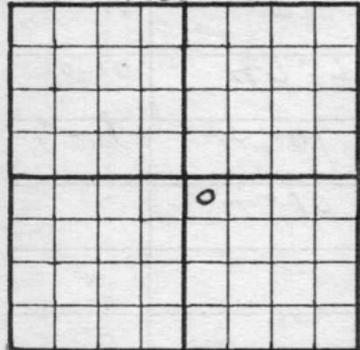

100% - Russell Cobb Jr.  
Shompson Bldg. Tulsa Ok.  
Call Tulsa 2-8157 (L.E. Wilsey)  
Bois Lerke - Geologist  
703-2814  
Map Co AM 5-1606 in  
supporting

10' @ 3100 5' @ 3700

NOTE: Show Sketch of Lease and Well Location in Above Space

Ft. from N. Line 2310 Ft. from S. Line \_\_\_\_\_

Ft. from W. Line 2310 Ft. from E. Line \_\_\_\_\_

Date	Depth	
		<u>Spd 5-28-55</u>
<u>5-27</u>		<u>M.C. R.I.</u>
<u>5-28</u>	<u>35'</u>	<u>Drilg.</u>
<u>5-30</u>		<u>8 5/8" @ 260' w/ 175 specm. P.D. 9:45 pm</u> <u>5-28-55.</u>
	<u>1295</u>	<u>Drilg.</u>
<u>5-31</u>	<u>1642</u>	<u>Drilg (Had cores in hole.</u> <u>Drilg ahead this morning)</u>
<u>6-1</u>	<u>2483</u>	<u>Drilg.</u>
<u>6-2</u>	<u>2815</u>	<u>Drilg.</u>

Drilg Co  
Mr. Bartlett going  
out @ 3900

Date	Depth	716491
6-3	3430	Dreg ( $3/4^\circ$ off)
6-4	3835	Dreg
6-5	4064	Dreg
6-6	4251	Making bit trip no Layton K. C. 3904 (-2671) (Broken to 3964. Solid line 3964. above that shaley lime. Break in K. C. 4069-85)
6-7	4425	Dreg
6-8	4615	On bottom after bit trip. (On miss. Running low may not drill to Simpson)
	4610	miss (-3377)
6-9	4691	Dreg ( $1 1/4^\circ$ off. 2790)
6-10	4737	Dreg ( $1^\circ$ off 4723)
6-11	4789	Dreg
6-12	4859	Dreg
6-13	4946	Dreg ( $2 3/4^\circ$ off. checking tool to see whether it is off)
	5095	Base miss (-3862)
6-14	5059	Dreg ( $2^\circ$ off. 5050) Dreg
6-15	5190	Simpson shale (-3957)
	5204	Simpson Id (3971)
	5205	Circs for top Simp Id.
	5212	R. T. D. taking DST w/20' anchors.

(2)

State Kansas County Harper

Company Russell Cobb, Jr. Inc Well No. 1


Farm C. D. Williams

Survey \_\_\_\_\_

Block No. \_\_\_\_\_ Sec. 9 Twp. 35 S Range 5 W

Co-Ord. \_\_\_\_\_ Elev. 1233 R.B.

*near 2nd Se*

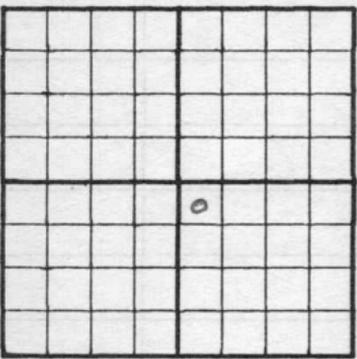

100% Russell Cobb, Jr. Inc

NOTE: Show Sketch of Lease and Well Location in Above Space

Ft. from N. Line

Ft. from S. Line

Ft. from W. Line

Ft. from E. Line

Date	Depth	
6-16	DST 5192-5212 op 1 1/2 hrs, cl 20'	gd bc. Rec 910' sw. 1FP-128, FFP-495', Bhp 2175'
	5212	R.T.O. Running log. Have orders to plug.
6-17	P & A	6-16-55