


Rice

KANSAS

Section 18 Township 18 Range 8-W

Well No. 3 Williams

Company Continental et al

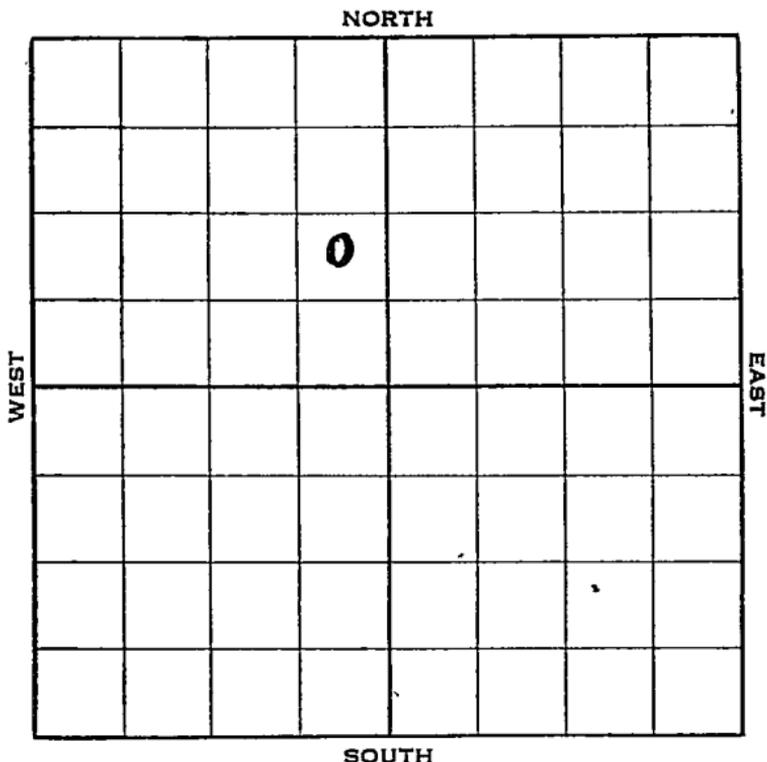

Sec. 13 Twp. 18 R. 8-W

Well No. #3 Williams Farm


Continental et al Company

_____ Ft. from N. Line

990 Ft. from S. Line

330 Ft. from E. Line

_____ Ft. from W. Line

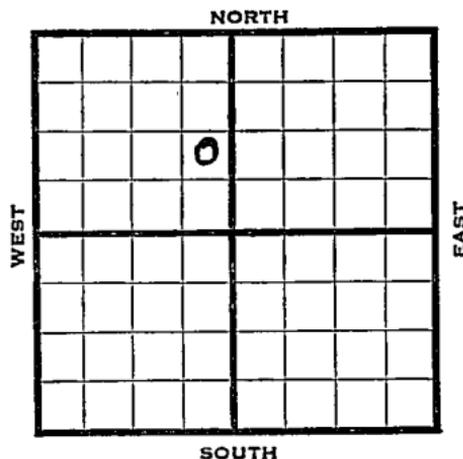

Elev. 1743

1938	REPORT
8/31	B. R. R.
9/9	10" - 215'. Dlg. 2245'.
9/16	Arb. 3194-96'. 7" - 3195'. RUST.
9/23	T. D. 3223'. 3100' oil. 3000 acid.
9/28	7" at 3195'. Arb. 3194'. T. D. 3223'. 3000 acid. Potential 2489 bbls.
COMPLETED	

Rice **KANSAS**

Map No. 45 Sec. 13 Twp. 18 R. 8W

Well No. 3 Williams

Continental etal Company

Contractor

COMPLETED

NE SE NW

SECTION PLAT

_____ Ft. from N. Line

990 Ft. from S. Line

330 Ft. from E. Line

_____ Ft. from W. Line

	0		

Location _____

RECORD

Rig up _____

Cased 7 in., 3195 ft.

Drilling and Remarks:

Sand Arb 3194

Gas _____

Oil _____

Total Depth 3223

3000 acid

PRODUCTION

POT 2489

1st 24 hrs. Nat. _____

1st 24 hrs. after shot _____

Gas _____ Cu. Ft.

Dry Hole _____

Abandoned _____

Date

SEP 28 1938 19

H. D. Hatfield Scout