


Section 13 Township 18 Range 8-W

Well No. #3 Zagic

Company Shell

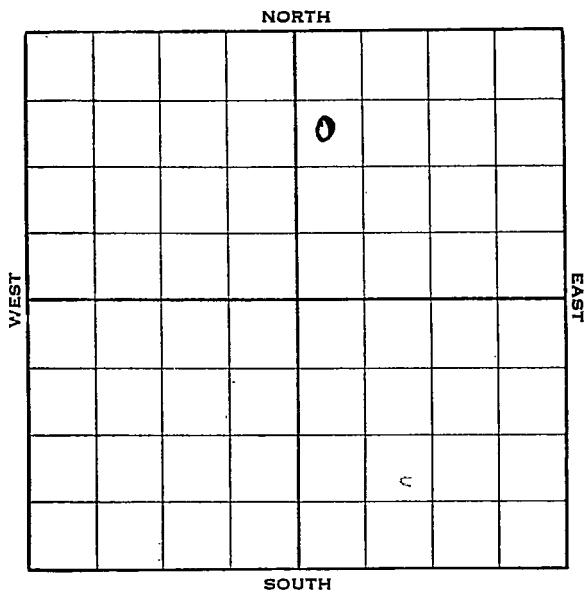

Sec. 13 Twp. 18 R. 8-W

Well No. #3 Zagie Farm _____
Shell Company _____


990 SW NW NE
 Ft. from N. Line

_____ Ft. from S. Line

_____ Ft. from E. Line

330 Ft. from W. Line

Elev. 1750

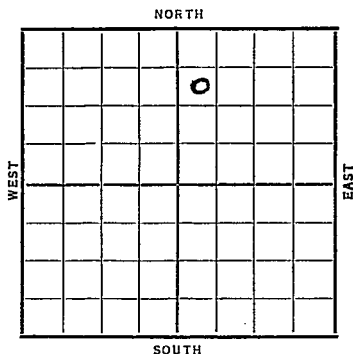

Date	REPORT
1938	
6/29	BRR
7/8	10" - 252'. WOC.
7/15	Dlg. 2495'.
7/22	Lans. 2795'. Arb. 3166'. T.D. 3173'. Stain oil.
	7" - 3167'. RUST.
7/29	T. D. 3226'. 3100' oil. 2000 acid.
8/3	7" at 3167'.
	Arb. 3166'.
	T. D. 3226'.
	2000 acid.
	Potential 2650 bbls.
	COMPLETED

Rice

KANSAS

Map No. 45 Sec. 13 Twp. 18 R. 8WWell No. 3 Zagio

Shell

Company

Contractor

FIRST REPORT

SW NW NE

SECTION PLAT

990 Ft. from N. Line

_____ Ft. from S. Line

_____ Ft. from E. Line

330 Ft. from W. Line

		0	

Location _____

Rig up _____

Drilling and Remarks:

BRR

RECORD

Cased _____ in., _____ ft.

Sand _____

Gas _____

Oil _____

Total Depth _____

PRODUCTION

1st 24 hrs. Nat. _____

1st 24 hrs. after shot _____

Gas _____ Cu. Ft.

Dry Hole _____

Abandoned _____

Date

JUN 29 1938 19

H. D. Hatfield

Scout

Rice

Map No. 45 Sec. 13 Twp. 18 R. 8WWell No. 3 ZagieShell

Company _____

Contractor _____

COMPLETED

SW NW NE

990 Ft. from N. Line

_____ Ft. from S. Line

_____ Ft. from E. Line

330 Ft. from W. Line

SECTION PLAT

		0	

Location _____

Rig up _____

Drilling and Remarks:

*2000 acid**POT 2650*

RECORD

Cased 7 in., 3167 ft.Sand ARB 3166

Gas _____

Oil _____

Total Depth 3226

PRODUCTION

1st 24 hrs. Nat. _____

1st 24 hrs. after shot _____

Gas _____ Cu. Ft.

Dry Hole _____

Abandoned _____

Date

AUG 3 - 1938 19

H. D. Hatfield Scout

✓
W. P. B.

S-513-A

CO. Rice ELEV. 1750

SEC. 13 TWP. 18 RGE. 8W

COMPANY Shell Oil NO. 3

FIRST REPORT
✓ DEC 26 57
COMPLETE

FARM Zajic

O. W. P. B.

LOC. SW NW NE

OWPB

Cg. 3132

Arb. 3166

GEOL. _____

CONTR. _____

POOL Geneseo-Edwards

SPUD _____

OTD 3226 7" @ 3167

PB 3162 20/ 3151-59

32/ 3139-17 500M-A

S/ 17 bf 5% oil 2 hr.

Comp. 1 bopd 435 bw

CO.
LSE.
NO.
SEC.
TWP.
RGE.

Twp. X Pool X

Co. X Fac. X

O. W. P. B.

5-513-B

County Rice Elev. 1750 DF
 Sec. 13 Twp. 18 Rge. 8W
 Company Shell Oil Co.
 Farm Name Zajic No. 3

TOPS	DEPTH	LOG	DATUM
Anh.			
Tp.			
H.			
Tr.			
Dg.			
B.L.			
L.	<u>2795</u>		
K.C.			
B.K.C.			
Ce.			
C.	<u>3132</u>		
M.			
M.			
K.			
Mz.			
Mq.			
V.			
S.			
S.			
A.	<u>3166</u>		
R.			
Pf.			
G.			
T.D.	<u>OTD</u>	<u>3226</u>	

Loc. in Sec. SW NW NE
(O.W.P.B.)

Geol. O. W. P. B.
 Cont.

Pool Genesee-Edwards

COMPLETE
FIRST REPORT
 MAR 26 1938

Date Comm. _____
OLD INFO: Spud 7/6/38, tops, was Arb prod then Cong prod.
NEW INFO: PB 2997, 140/2863-73, 1000A, P 30 BO + 10 BWPD, COMPLETE from Lans. 2863-73/

Co.
Lse.
No.
Sec.
T.
R.