


Section 13 Township 18 Range 8 W

Well No. # 4 Lewis "A"

Company Continental et al

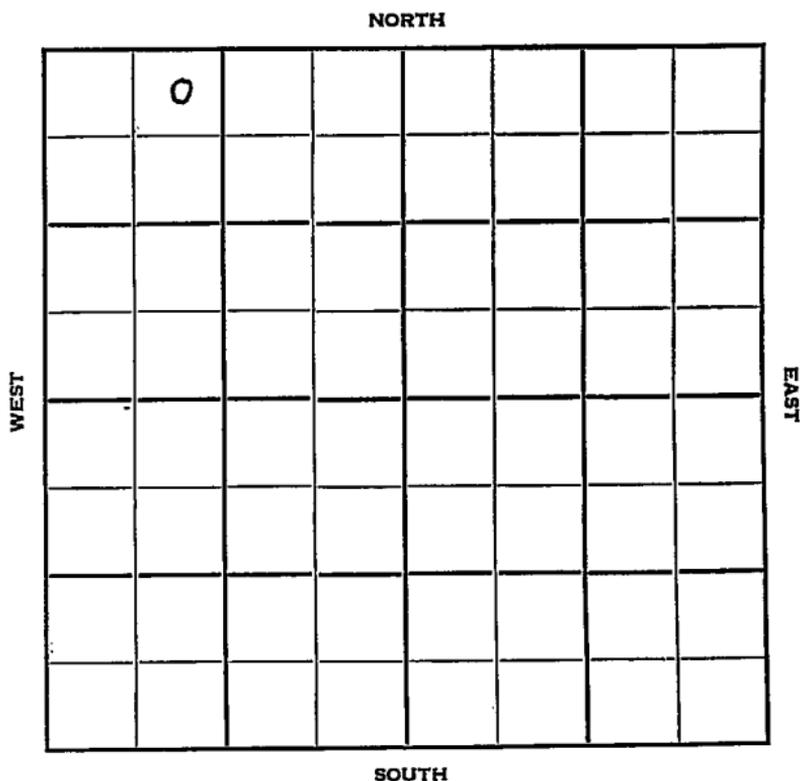

Rice

KANSAS 8W ✓

Sec. 13 Twp. 18 R.

Well No. #4 Lewis "A" Farm

Continental et al Company

Anschutz Drlg. - Contr. Contractor

Geneseo Pool


330' Ft. from N. Line

 Ft. from S. Line

 Ft. from E. Line

990' Ft. from W. Line

NE NW NW

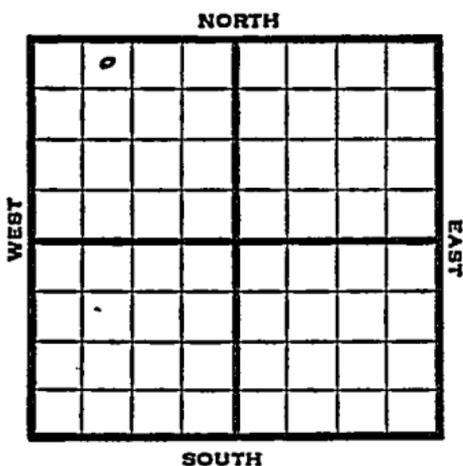

1951 Elev. 1752' REPORT

3/28 Location
5/29 Spud 3-29-51
Oil Well TD 3225
10" @ 312
Arb. 3192
DST 3191-3200 opn 10 min.
Rec. 510' free oil DST 3200-05
opn 5 min. Rec. 465' free oil
DST 3205-10 opn 1 hr Rec. 195'
free oil DST 3210-15 opn 5 min
Rec. 300' free oil Lans. 2798
DST 3215-20 opn 5 min. Rec. 185'
free oil DST 3220-25 opn 5 min
Rec. 90' ocm 300' sw TD 3225
5" @ 3221 60/3192-3207 FU 2550
oil 2 hr S/285 bo 8 hr
Comp. 2865 bopd

COMPLETED

County Rice State Kansas

Sec. 13 (Blk.) 18 (Sur.) 8W Map No.

Operator Continental etal.

Well No. 4 Farm Lewis "A"

Elev. 1752 Location NE NW NW

0					

330 Ft. From N Line NW

990 Ft. From W Line Quarter

Ist. Report

Completion MAY 9 1951

Remarks Geneseo Pool

Anschutz Drlg. - Contr.

Spudding Date 3-29-51

Drlg. Data Oil well TD 3225

10" @ 312 Arb. 3192 DST 3191-3200

open 10 min. Rec. 510' free oil

DST 3200-05 open 5 min. Rec. 465' free

oil DST 3205-10 open 1 hr. Rec. 195'

free oil DST 3210-15 open 5 min.

Rec. 300' free oil Lans. 2798 DST 3215-

20 open 5 min. Rec. 185' free oil

DST 3220-25 open 5 min. Rec. 90' ocm

300' sw TD 3225 5" @ 3221 60/ 3192-

3207 FU 2550' oil 2 hr. S/ 285 bo 8 hr

Comp. 2865 bopd.