

Rice


KANSAS

Form 51-5M-11-38-Palace

Section 13 Township 18- Range 8-W

Well No. #4 Pickerill

Company Continental et al

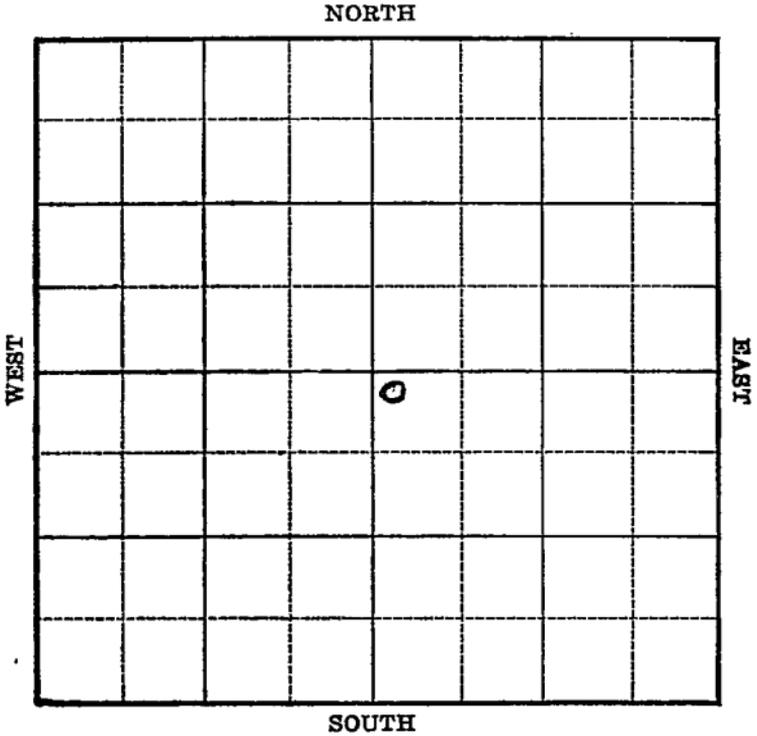

Sec. 13 Twp. 18 R. 8-W

Well No. #4 Pickerill Farm


Continental et al Company

330 Ft. from N. Line

_____ Ft. from S. Line

_____ Ft. from E. Line

330 Ft. from W. Line

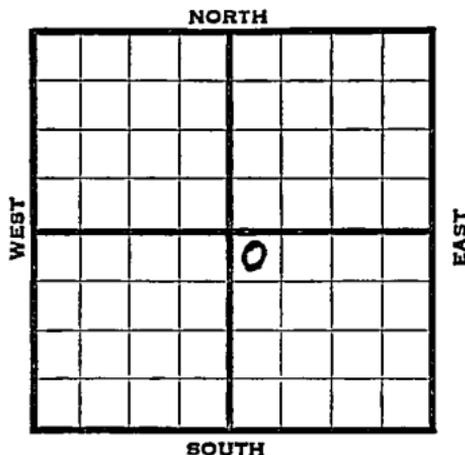

Elev. 1727'.

1938	REPORT
11/16	Cellar.
11/25	10" - 222'. Dlg. 1130'.
12/2	Drlg. 3160'.
12/9	Arb. 3210-14' T. D. 7" - 3211'. Drilled plug. 3000' oil. Running tubing.
12/14	7" - 3211'. Arb. 3210'. T. D. 3214'. 2000 acid. Pump 782 bbls. 8 hours. Potential 2347 bbls. No water.
	COMPLETED

Rice

KANSAS

Map No. 45 Sec. 13 Twp. 18 R. 8W

Well No. 4 Pickerill

Continental etal Company

Contractor

FIRST REPORT

SECTION PLAT

NW SE

330 Ft. from N. Line

_____ Ft. from S. Line

_____ Ft. from E. Line

330 Ft. from W. Line

		0	

Location _____

Rig up _____

Drilling and Remarks:
Cellar

RECORD

Cased _____ in., _____ ft.

Sand _____

Gas _____

Oil _____

Total Depth _____

PRODUCTION

1st 24 hrs. Nat. _____

1st 24 hrs. after shot _____

Gas _____ Cu. Ft.

Dry Hole _____

Abandoned _____

Date

NOV 16 1938 19

H. D. Hatfield Scout

Rice **KANSAS**

Map No. 45 Sec. 13 Twp. 18 R. 8W

Well No. 4 Pickerill

Continental etal Company

Contractor

COMPLETED

SECTION PLAT

NW SE
330 Ft. from N. Line
 _____ Ft. from S. Line
 _____ Ft. from E. Line
330 Ft. from W. Line

		0	

Location _____

Rig up _____

Drilling and Remarks:

Good acid.

P-78 2/8

POT 2347

Now Tr

RECORD

Cased 7 in., 3211 ft.

Sand Arb 3210

Gas _____

Oil _____

Total Depth 3214

PRODUCTION

1st 24 hrs. Nat. _____

1st 24 hrs. after shot _____

Gas _____ Cu. Ft.

Dry Hole _____

Abandoned _____

Date

DEC 13 1938 19

H. D. Hatfield Scout