

O.W.W.O.


KANSAS

Rice

Section 13 Township 18 Range 8-W

Well No. 4 Zagic<sup>J</sup>

Company Shell

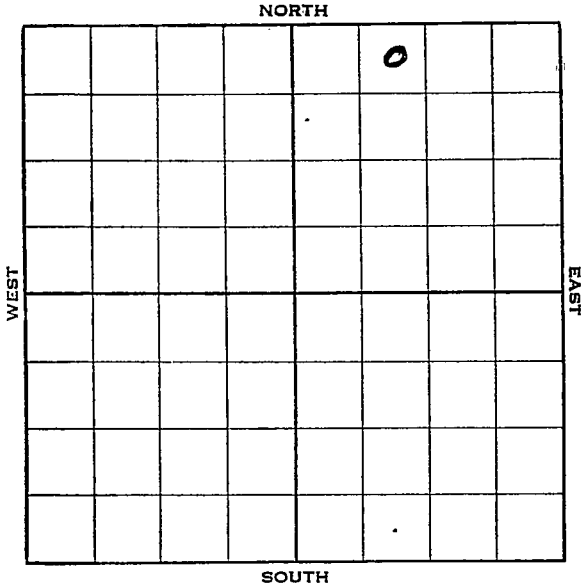

Sec. 13 Twp. 18 R. 8-W

Well No. #4 Zagie Farm \_\_\_\_\_  
Shell Company \_\_\_\_\_


330 Ft. from N. Line

\_\_\_\_\_ Ft. from S. Line

\_\_\_\_\_ Ft. from E. Line

990 Ft. from W. Line

Elev. 1748

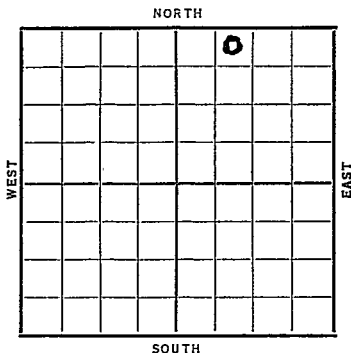

Date	REPORT
1938	
7/13	Location
7/22	R U R.
7/29	S. H.
8/5	10" - 225' - Lans. 2785'. Arb. 3159-61' S. O.
	7" - 3160' RUST.
8/12	T.D. 3224' H.F.O. 2000 acid.
8/17	7" at 3160'.
	Arb. 3159'.
	T. D. 3224'.
	2000 acid.
	Pump 444 bbls. 4 hrs. & 463 bbls.
	4 hrs.
	Potential 2662 bbls.
	COMPLETED
	OVER

1956

**O.W.W.O.**

8-15 Old info- OTD 3224; 7" @ 3160;  
Was Arb. producer;

New info - PB 3155; 56/ 3139-53;  
swb 2 boph, no wtr. 11 hrs., 250 A  
sd - oil frac;  
Swb & Bail load; POP;  
P/ 70 bo no wtr., 18 hrs. .  
P/ 38 bo no wtr., 22 hrs.  
P/ 24 bo no wtr. 24 hrs.  
Grav. 40.5°

From Congl. 3139-53  
L. 2785'; C. 3133'; A. 3159';

**FIRST REPORT**



**COMPLETED**

Rice **KANSAS**

Map No. 45 Sec. 13 Twp. 18 R. 8W

Well No. 4 Zagie  
Shell Company

Contractor

**FIRST REPORT**

**SECTION PLAT**

**NE NW NE**  
330 Ft. from N. Line  
\_\_\_\_\_ Ft. from S. Line  
\_\_\_\_\_ Ft. from E. Line  
990 Ft. from W. Line

		0	

Location X

Rig up \_\_\_\_\_

Drilling and Remarks:

**RECORD**

Cased \_\_\_\_\_ in., \_\_\_\_\_ ft.

Sand \_\_\_\_\_

Gas \_\_\_\_\_

Oil \_\_\_\_\_

Total Depth \_\_\_\_\_

**PRODUCTION**

1st 24 hrs. Nat. \_\_\_\_\_

1st 24 hrs. after shot \_\_\_\_\_

Gas \_\_\_\_\_ Cu. Ft.

Dry Hole \_\_\_\_\_

Abandoned \_\_\_\_\_

Date

JUL 13 1938 19

H. D. Hatfield Scout

Map No. 45 Sec. 13 Twp. 18 R. 8WWell No. 4 ZagieShell

Company \_\_\_\_\_

Contractor \_\_\_\_\_

**COMPLETED**

## SECTION PLAT

330 NE NW NE  
Ft. from N. Line

\_\_\_\_\_ Ft. from S. Line

\_\_\_\_\_ Ft. from E. Line

990 Ft. from W. Line

		0	

Location \_\_\_\_\_

Rig up \_\_\_\_\_

Drilling and Remarks:

*2000 Acid*  
*P-444/4 x 46 3/4*

*POT 2662*

## RECORD

Cased 7 in., 3160 ft.Sand Arb 3159

Gas \_\_\_\_\_

Oil \_\_\_\_\_

Total Depth 3224

## PRODUCTION

1st 24 hrs. Nat. \_\_\_\_\_

1st 24 hrs. after shot \_\_\_\_\_

Gas \_\_\_\_\_ Cu. Ft.

Dry Hole \_\_\_\_\_

Abandoned \_\_\_\_\_

Date

AUG 17 1938 19

H. D. Hatfield

Scout

O.W.W.O.

FORM 513 SUNRA

County Rice Elev. 1778 DF  
 Sec. 13 Twp. 18S Rge. 8W  
 Company Shell Oil Co.  
 Farm Name F. Zajic No. 4

OWWO

TOPS	DEPTH	LOG	DATUM
Anb.			
Tr.			
H.			
Tr.			
Dg.			
Bl.			
L.	<u>2785</u>		
K.C.			
B.K.C.			
Ce.			
C.	<u>3133</u>		
M.			
M.			
K.			
Mz.			
Me.			
V.			
S.			
S.			
A.	<u>3159</u>		
R.			
PE.			
G.			
T.D.			

Loc. in Sec. NE NW NE

Geol. \_\_\_\_\_  
Contr. \_\_\_\_\_

Pool Geneseo  
Edwards

COMPLETE  
FIRST REPORT

AUG 15 '56

Date Comm. \_\_\_\_\_  
 Old info - OTD 3224; 7" 3160; was Arb. prod.  
 New info - PB 3155; 56/3139-53; swb 2 beph  
 no wtr. 11 hrs.; 250 A; sd-oil frac;  
 swb & bail ld; POP; pmp 70 bo no wtr.  
 18 hrs.; pmp 38 bo no wtr. 22 hrs.;  
 pmp 24 bo no wtr. 24 hrs. 40.5° grav.  
 from Congl. 3139-53

12