


Rice

KANSAS

Section 13 Township 18 Range 8-W

Well No. 6 Nickel

Company Continental et al

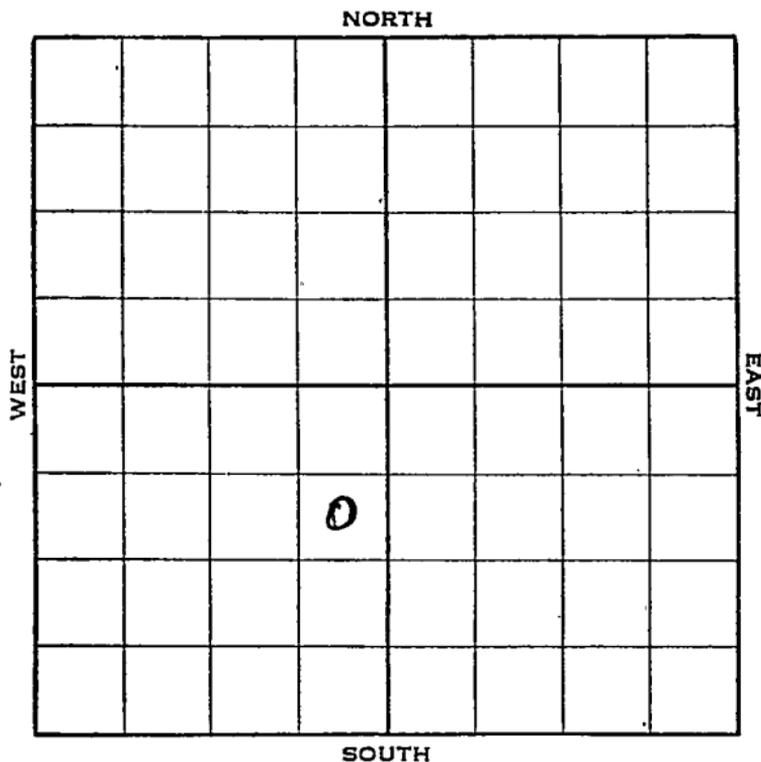

Sec. 13 Twp. 18 R. 8-W

Well No. #6 Nickel Farm \_\_\_\_\_


Continental et al Company

990 Ft. from N. Line

\_\_\_\_\_ Ft. from S. Line

330 Ft. from E. Line

\_\_\_\_\_ Ft. from W. Line

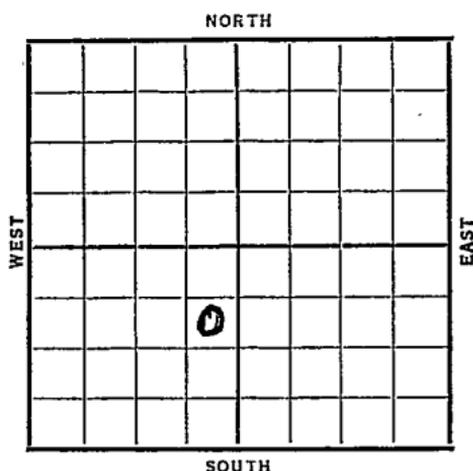

Date	REPORT
1938	
3/23	Location
4/1	10" @ 223'. Arb. 3227'.
	T.D. 3228'. S.O. 7" @ 3227'.
	RUST.
4/8	T.D. 3232'. 3150' oil.
4/13	7" @ 3227'.
	Arb. 3227'.
	T.D. 3232'.
	Potential 1117 bbls., Nat'l.
	<b>COMPLETED</b>

Map No. 45 Sec. 13 Twp. 18 R. 8WWell No. 6 NickelContinental etal Company

Contractor

## FIRST REPORT

## SECTION PLAT

SE NE SW  
990 Ft. from N. Line

Ft. from S. Line

330 Ft. from E. Line

Ft. from W. Line

		0	

Location X

Rig up \_\_\_\_\_

Drilling and Remarks:

## RECORD

Cased \_\_\_\_\_ in., \_\_\_\_\_ ft.

Sand \_\_\_\_\_

Gas \_\_\_\_\_

Oil \_\_\_\_\_

Total Depth \_\_\_\_\_

## PRODUCTION

1st 24 hrs. Nat. \_\_\_\_\_

1st 24 hrs. after shot \_\_\_\_\_

Gas \_\_\_\_\_ Cu. Ft.

Dry Hole \_\_\_\_\_

Abandoned \_\_\_\_\_

Date

MAR 23 1938H. D. Hatfield Scout

Rice

KANSAS

Map No. 45 Sec. 13 Twp. 18 R. 8WWell No. 6 NickelContinental etal Company

Contractor

**COMPLETED**

SE NE SW

990 Ft. from N. Line       Ft. from S. Line330 Ft. from E. Line       Ft. from W. Line

## SECTION PLAT


Location \_\_\_\_\_

Rig up \_\_\_\_\_

Drilling and Remarks:

*PT 1117*  
*NAT*

## RECORD

Cased 7 in., 3227 ft.Sand Arb 3227

Gas \_\_\_\_\_

Oil \_\_\_\_\_

Total Depth 3232

## PRODUCTION

1st 24 hrs. Nat. \_\_\_\_\_

1st 24 hrs. after shot \_\_\_\_\_

Gas \_\_\_\_\_ Cu. Ft.

Dry Hole \_\_\_\_\_

Abandoned \_\_\_\_\_

Date

APR 13 1938

19

H. D. Hatfield Scout