


Rice

FORM 51 5M 2-38 TPCO.

Section: 13 Township 18 Range 8-W

Well No. 6 Zagic

Company Shell

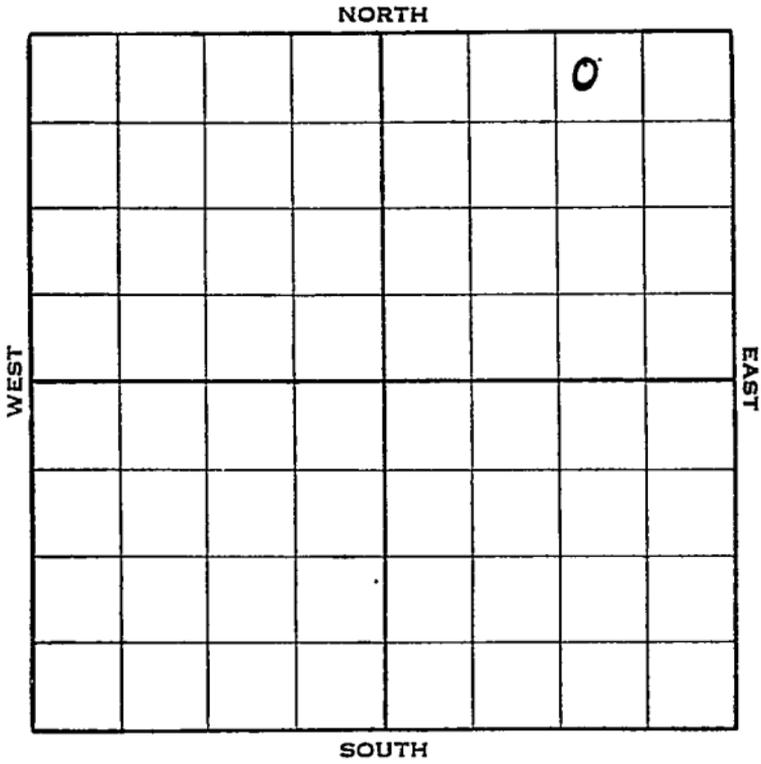

KANSAS

Rice

Sec. 13 Twp. 18 R. 8-W

Well No. #6 Zagie Farm _____

Shell Company _____


330 Ft. from N. Line

_____ Ft. from S. Line

1045 Ft. from E. Line

_____ Ft. from W. Line

Elev. 1741

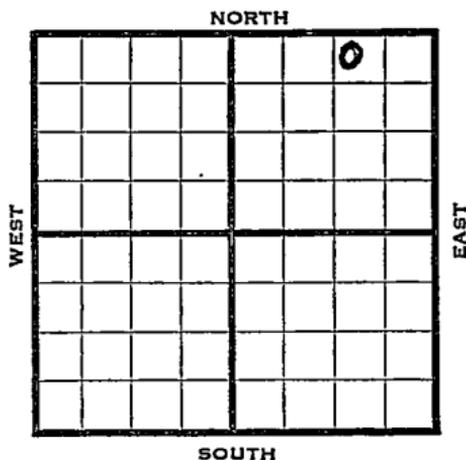

1938	REPORT
8/17	R U R
8/26	10" - 251'. Dlg. 2230'.
9/2	Topeka 2414'. Lans. 2788'.
	Cong. 3134'. Arb. 3180-82'.
	S. O. 7" - 3181'. RUST.
9/7	Arb. 3180'.
	T. D. 3216'.
	Potential 2544 bbls.
	COMPLETED

Rice **KANSAS**

Map No. 45 Sec. 13 Twp. 18 R. 8W

Well No. 6 Zagio

Shell

Company _____

Contractor _____

FIRST REPORT

SECTION PLAT

330 ^{NW NE NE} Ft. from N. Line

_____ Ft. from S. Line

1045 Ft. from E. Line

_____ Ft. from W. Line

			0

Location _____

Rig up _____

Drilling and Remarks:

RUR

RECORD

Cased _____ in., _____ ft.

Sand _____

Gas _____

Oil _____

Total Depth _____

PRODUCTION

1st 24 hrs. Nat. _____

1st 24 hrs. after shot _____

Gas _____ Cu. Ft.

Dry Hole _____

Abandoned _____

Date

AUG 17 1938

19

H. D. Hatfield Scout

Rice

KANSAS

Map No. 45 Sec. 13 Twp. 18 R. 8W

Well No. 6 Zagie

Shell Company

Contractor

COMPLETED

SECTION PLAT

NW NE NE
330 Ft. from N. Line
 _____ Ft. from S. Line
1045 Ft. from E. Line
 _____ Ft. from W. Line

			o

Location _____

Rig up _____

Drilling and Remarks:

pot. 2544

RECORD

Cased _____ in., _____ ft.

_____ *3180*

Gas _____

Oil _____

Total Depth 3216

PRODUCTION

1st 24 hrs. Nat. _____

1st 24 hrs. after shot _____

Gas _____ Cu. Ft.

Dry Hole _____

Abandoned _____

Date

SEP 7 - 1938

19

ORVAL MANNSCHRECK

Scout