

KANSAS


Rice

FORM 51 5M 2-38 TPCO.

Section 13 Township 18 Range 8-~~W~~

Well No. #12 Zagie

Company Shell

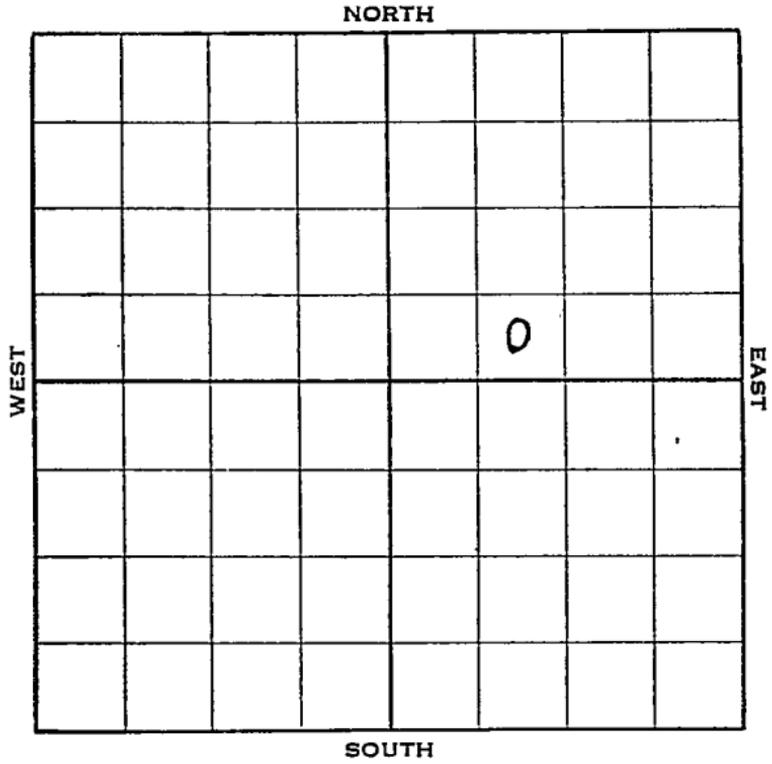

Rice **KANSAS**

Map No. 45 Sec. 13 Twp. 18 R. 8W

Well No. 12 Zagie

Shell

Company

Contractor

FIRST REPORT

SE SW NE

SECTION PLAT

		0	

_____ Ft. from N. Line

330 Ft. from S. Line

_____ Ft. from E. Line

990 Ft. from W. Line

Location _____

Rig up _____

Drilling and Remarks:

BRR

RECORD

Cased _____ in., _____ ft.

Sand _____

Gas _____

Oil _____

Total Depth _____

PRODUCTION

1st 24 hrs. Nat. _____

1st 24 hrs. after shot _____

Gas _____ Cu. Ft.

Dry Hole _____

Abandoned _____

Date

NOV 2 - 1938

19

H. D. Hatfield

Scout

Rice

KANSAS

Map No. 45 Sec. 13 Twp. 18 R. 8W

Well No. 12 Zagie

Shell

Company

Contractor

COMPLETED

SE SW NE

_____ Ft. from N. Line

330 Ft. from S. Line

_____ Ft. from E. Line

990 Ft. from W. Line

SECTION PLAT

		0	

Location _____

Rig up _____

Drilling and Remarks:

P. 877/8 No wt
POT 2630

RECORD

Cased 7 in., 3211 ft.

Sand 4-6 3210

Gas _____

Oil _____

Total Depth 3227

PRODUCTION

1st 24 hrs. Nat. _____

1st 24 hrs. after shot _____

Gas _____ Cu. Ft.

Dry Hole _____

Abandoned _____

Date

NOV 30 1938

19

H. D. Hatfield

Scout