



Sec. 13 Twp. 18 R. 8-W

Well No. #5 Zagie Farm \_\_\_\_\_

Shell Company \_\_\_\_\_


\_\_\_\_\_ Ft. from N. Line

990 Ft. from S. Line

\_\_\_\_\_ Ft. from E. Line

330 Ft. from W. Line

Elev. 1740

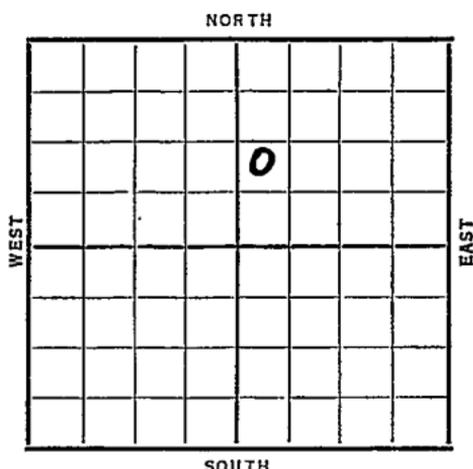

Date	REPORT
1938	
8/3	B. R. R.
8/12	10" - 258'. Dlg. 2380'.
8/19	Topeka 2432'. Lans. 2793'.
	Cong. 3139'. Arb. 3189'.
	7" - 3190'. RUST.
8/24	7" at 3190'.
	Arb. 3189'.
	T. D. 3215'.
	2000 acid.
	Potential 2520 bbls.
	COMPLETED

Rice

Map No. 45 Sec. 13 Twp. 18 R. 8W

Well No. 5 Zaglo

Shell Company

Contractor

FIRST REPORT

SECTION PLAT

NW SW NE

\_\_\_\_\_ Ft. from N. Line

990 Ft. from S. Line

\_\_\_\_\_ Ft. from E. Line

330 Ft. from W. Line

		0	

Location \_\_\_\_\_

Rig up \_\_\_\_\_

Drilling and Remarks:

**BRR**

RECORD

Cased \_\_\_\_\_ in., \_\_\_\_\_ ft.

Sand \_\_\_\_\_

Gas \_\_\_\_\_

Oil \_\_\_\_\_

Total Depth \_\_\_\_\_

PRODUCTION

1st 24 hrs. Nat. \_\_\_\_\_

1st 24 hrs. after shot \_\_\_\_\_

Gas \_\_\_\_\_ Cu. Ft.

Dry Hole \_\_\_\_\_

Abandoned \_\_\_\_\_

Date

AUG 3 - 1938 19

H. D. Hatfield

Scout

Rice

KANSAS

Map No. 45 Sec. 13 Twp. 18 R. 8WWell No. 5 ZagieShell

Company \_\_\_\_\_

Contractor \_\_\_\_\_

**COMPLETED**

NW SW NE

\_\_\_\_\_ Ft. from N. Line

990 Ft. from S. Line

\_\_\_\_\_ Ft. from E. Line

330 Ft. from W. Line

## SECTION PLAT

		0	

Location \_\_\_\_\_

Rig up \_\_\_\_\_

Drilling and Remarks:

*2000 acid**POT 2520*

## RECORD

Cased 7 in., 3190 ft.Sand Arb 318.9

Gas \_\_\_\_\_

Oil \_\_\_\_\_

Total Depth 3215

## PRODUCTION

1st 24 hrs. Nat. \_\_\_\_\_

1st 24 hrs. after shot \_\_\_\_\_

Gas \_\_\_\_\_ Cu. Ft.

Dry Hole \_\_\_\_\_

Abandoned \_\_\_\_\_

Date

AUG 24 1938

19

H. D. Hatfield Scout