


O.W.W.O.

Section 13 Township 18 Range 8-W

Well No. #9 Zagio


Company Shell

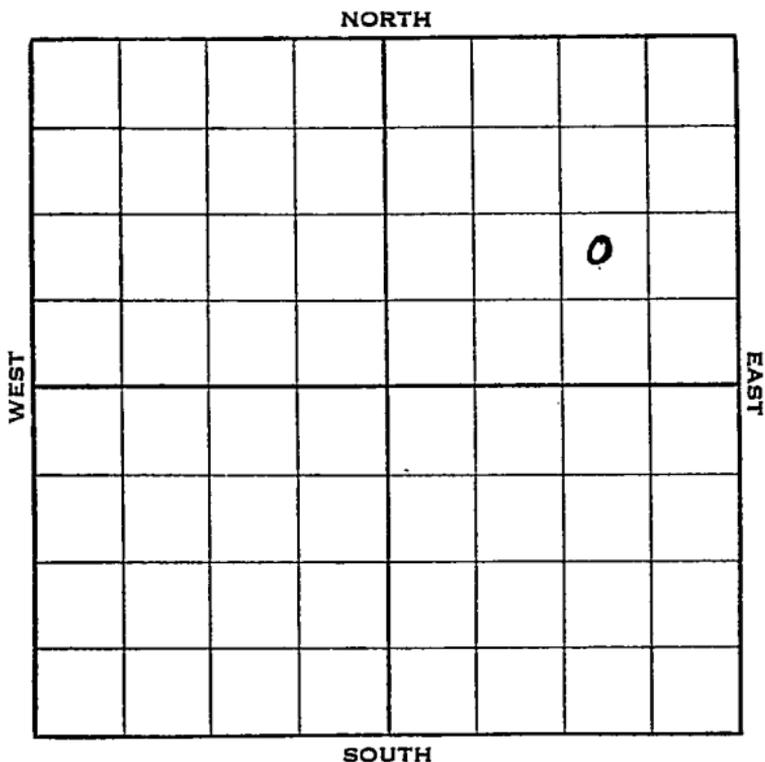

Sec. 13 Twp. 18 R. 8-W

Well No. #9 Zagie Farm \_\_\_\_\_  
Shell Company \_\_\_\_\_

\_\_\_\_\_ Ft. from N. Line  
990 Ft. from S. Line  
990 Ft. from E. Line  
 \_\_\_\_\_ Ft. from W. Line

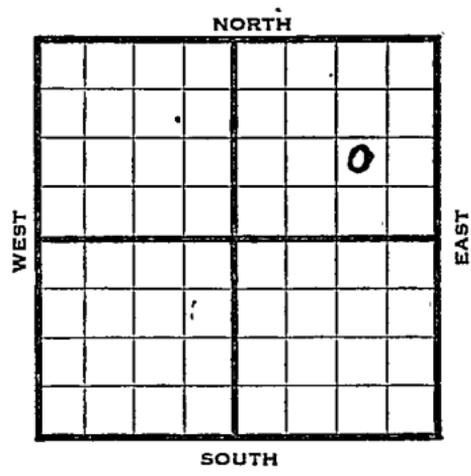

**Elev. 1739'.**

REPORT	
1938	
9/28	10" - 250'. WOC.
10/7	Dlg. 2889'.
10/14	Cong. 3157'. Arb. 3203-05'. 7" - 3205'. RUST.
10/19	7" - 3205'. Arb. 3203'. T. D. 3227'. 2000 acid. Potential 2788 bbls.
<b>COMPLETED</b>	
<b>O. W. P. B.</b>	
1951	
12/5	Oil well TD 3045'. Top 2445' Lans. 2807' Cong. 3157' Simp. 3189' Arb. 3203-27' OTD 7" @ 3205' PB 3178' 20/3166-71 36/3251-61 Hydro S/135 BF PB 3045 32/2874-82 S/1-1/2 BOPH 9 hr. 2000 A S/15 BOPH 14 hr. Comp. 279 BOPD 15 BW
<b>COMPLETED OVER</b>	

1956

**O.W.W.O.**

8-15 Old Info - OTD 3227: 7" @ 3205;  
Was Arb & Congl. producer

New info - PB 3020; 40/2875-85;  
5000 A;

POP; rec. ld.; 25 bo & 505 bwpd from  
Lsg. 2875-85

Grav. 29.9°

Tp. 2445'; L. 2807'; C. 3157';

Sh. 3189'; A. 3203';

**FIRST REPORT**

  
**COMPLETED**

Map No. 45 Sec. 13 Twp. 18 R. 8W

Well No. 9 Zagio

Shell Company

Contractor

**FIRST REPORT**

**SECTION PLAT**

NW SE NE

\_\_\_\_\_ Ft. from N. Line

990 Ft. from S. Line

990 Ft. from E. Line

\_\_\_\_\_ Ft. from W. Line

			0

Location \_\_\_\_\_

Rig up \_\_\_\_\_

Drilling and Remarks:

10" - 250  
W OC

**RECORD**

Cased \_\_\_\_\_ in., \_\_\_\_\_ ft.

Sand \_\_\_\_\_

Gas \_\_\_\_\_

Oil \_\_\_\_\_

Total Depth \_\_\_\_\_

**PRODUCTION**

1st 24 hrs. Nat. \_\_\_\_\_

1st 24 hrs. after shot \_\_\_\_\_

Gas \_\_\_\_\_ Cu. Ft.

Dry Hole \_\_\_\_\_

Abandoned \_\_\_\_\_

Date

SEP 28 1938 19

H. D. Hatfield Scov

Rice

KANSAS

Map No. \_\_\_\_\_ Sec. 13 Twp. 18 R. 8WWell No. 9 ZagioShell Company

Contractor

**COMPLETED**

NW SE NE

\_\_\_\_\_ Ft. from N. Line

990 Ft. from S. Line990 Ft. from E. Line

\_\_\_\_\_ Ft. from W. Line

**SECTION PLAT**

			0

Location \_\_\_\_\_

Rig up \_\_\_\_\_

Drilling and Remarks:

*2000 acid**POT 2788***RECORD**Cased 7 in., 3205 ft.Sand Arb 3203

Gas \_\_\_\_\_

Oil \_\_\_\_\_

Total Depth 3227**PRODUCTION**

1st 24 hrs. Nat. \_\_\_\_\_

1st 24 hrs. after shot \_\_\_\_\_

Gas \_\_\_\_\_ Cu. Ft.

Dry Hole \_\_\_\_\_

Abandoned \_\_\_\_\_

Date

H. D. Hatfield

OCT 10 1938 19

Scout

County Rice State Kansas

Sec: 13 (Blk. Twp.) 18 (Sur. Rge.) SW Map No.

Operator Shell

Well No. 9 Farm Zajic

Elev. 1739 Location NW SE NE


FIRST REPORT

COMPLETE

999 Ft. From S Line NE

998 Ft. From R Line Quarter

Ist. Report DEC 5 1951

Completion DEC 5 1951

Remarks OWPB

**O. W. P. B.**

Spudding Date

Drig. Data Oil well TD 3045

Top. 2445 Lans. 2807 Cong. 3157

Simp. 3189 Arb. 3203-27 OTD 7" @ 3205

PB 3178 20/ 3166-71 36/ 3251-61

Hydro. S/ 135 bF PR 3045 32/ 2874-82

S/ 1 1/3 boph 9 hr. 2000 A S/ 15 boph

14 hr. Comp. 279 bopd 15 bw

J. E. TYRA

O.W.W.O.

County Rice Elev. 1739 DF  
 Sec. 13 Twp. 18S Rge. 8W  
 Company Shell Oil Co.  
 Farm Name E. Zajic No. 9

TOPS	DEPTH	LOG	DATUM
Anh.			
Tp.	<u>2445</u>		
H.			
Tr.			
Dg.			
BL.			
L.	<u>2807</u>		
K.C.			
B.K.C.			
Ce.			
C.	<u>3157</u>		
M.			
M.			
K.			
Mz.			
Mo.			
V.			
S. Sh	<u>3189</u>		
S.			
A	<u>3203</u>		
R.			
PE.			
G.			
T.D.			

OWWO  
 Loc. in Sec. NW SE NE  
999' FSL X  
986' FEL NE 1/4  
 Geol. \_\_\_\_\_  
 Contr. \_\_\_\_\_  
 Pool Genesee  
Edwards


COMPLETE REPORT

Date Comm. Old info - OTD 3227; 7" 3205; AUG 15 '50  
was Arb. & Congl. producer  
New info - PB 3020; 40/2875-85; 5000 A;  
POP; rec. ld.; 25 bp & 505 bwpd from  
Lsg. 2875-85 29.9 grav.

Dept P S 201A

157

12

Co.  
Lse.  
No.  
Sec.  
T.  
R.