


DX 78-1

Section 13 Township 18 Range 8W

Well No. #10 P. Nickel

Company Continental et al

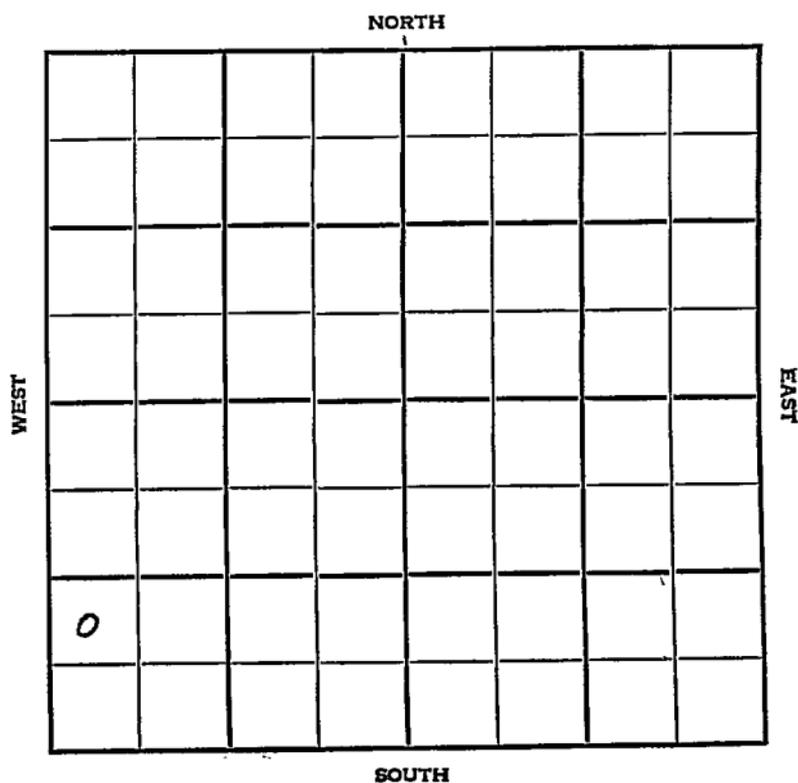

Rice

KANSAS

SEC.	TWP.	R.
13	18	8W


WELL NO. #10 P. Nickel FARM

COMPANY Continental et al.

CONTRACTOR G-M-R

Geneseo-Edwards Pool

_____ Ft. from N. Line
 990 _____ Ft. from S. Line
 _____ Ft. from E. Line
 330 _____ Ft. from W. Line

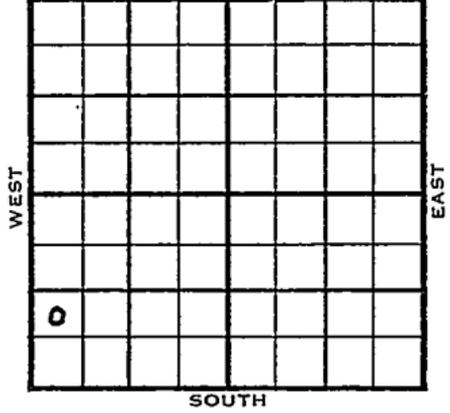

NW SW SW

1954	ELEVATION	REPORT
	1731' IS 1734 RB	

9/1

Spud 8-30-54
 8" @ 315'
 WOC.

11/3

Spud 8-30-54
 Oil Well
 TD 3216'
 8" @ 315'
 Heeb 2651', Br. Lime 2779', Lans 2809'
 DST 2830'-38' opn 1 hr, rec 35' Mud 760
 B KC 3114', Cong 3128'
 DST 3167'-80' opn 1 hr, rec 340' s.w.
 890# Arb. 3209'
 TD 3214'
 DST 3210'-14' opn 1 hr, FU 1650' gas
 in pipe. 180' muddy oil 930#
 Schl Tops: Heeb 2649', Br. Lime 2778'
 Lans 2808', Simp sh. 3162', Simp sd
 3166', Arb 3209',
 5" @ 3211'
 DD 3216' FU 350' oil 1 hr. S/ 21 bo
 3 bw 6 hr. 20/ 3183-90 S/ 12 bw 6
 hr. 24/ 3166-74 S/ 12 1/2 bw 5 hr. S/ 11
 bo 3 bw 6 hr.
 Comp 26 bopd 84% Wtr.

COMPLETED

