


Section 13 Township 18 Range 8-W

Well No. 13 Zagic

Company Shell

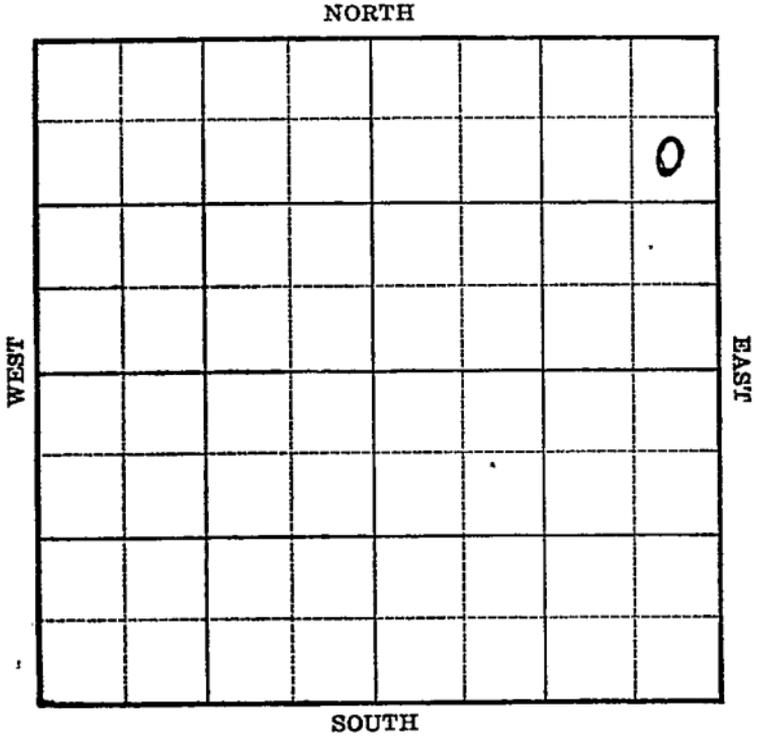

Sec. 13 Twp. 18 R. 8

Well No. #13 Zagie Farm _____
Shell Company _____


990 Ft. from N. Line

_____ Ft. from S. Line

330 Ft. from E. Line

_____ Ft. from W. Line

Elev. 1737

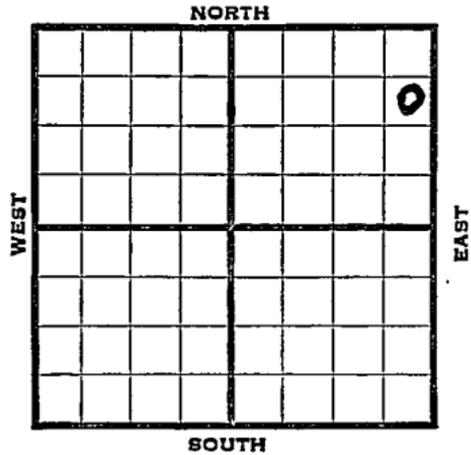

1938	REPORT
11/30	B. R. R.
12/9	T. D. 253'. Running 10".
12/15	10" - 228'. Dr Ig. - 2721'.
12/23	Topeka 2442'. Lens. '28.01'. Cong. 3149'. Arb. 3201'. 7" - 3202'. T. D. 3209'.
	2800' oil 3½ hrs.
	Swab 460 oil 4 hrs.
12/28	7" - 3202'.
	Arb. 3201'.
	T. D. 3217'.
	Pump 816 bbls. 8 hrs.
	Potential 2449 bbls.
	No water.
	COMPLETED

Map No. 45 Sec. 13 Twp. 18 R. 8W

Well No. 13 Zagia

Shell

Company

Contractor

FIRST REPORT

SECTION PLAT

SE NE NE

990 Ft. from N. Line

_____ Ft. from S. Line

330 Ft. from E. Line

_____ Ft. from W. Line

			0

Location _____

Rig up _____

Drilling and Remarks:

BRR

RECORD

Cased _____ in., _____ ft.

Sand _____

Gas _____

Oil _____

Total Depth _____

PRODUCTION

1st 24 hrs. Nat. _____

1st 24 hrs. after shot _____

Gas _____ Cu. Ft.

Dry Hole _____

Abandoned _____

Date

NOV 30 1938 19

H. D. Hatfield Scout

Rice

KANSAS

Map No. 45 Sec. 13 Twp. 18 R. 8WWell No. 13 ZagieShell

Company

Contractor

COMPLETED

SECTION PLAT

990 SE NE NE
Ft. from N. Line

____ Ft. from S. Line

330 Ft. from E. Line

____ Ft. from W. Line

				0

GENESEO POOL

Location _____

Rig up _____

Drilling and Remarks:

*P- 816/8**POT 2449.
NO WTR*

RECORD

Cased 7 in., 3202 ft.Sand ARB 3201

Gas _____

Oil _____

Total Depth 3217

PRODUCTION

1st 24 hrs. Nat. _____

1st 24 hrs. after shot _____

Gas _____ Cu. Ft.

Dry Hole _____

Abandoned _____

Date

DEC 28 1938 19

H. D. Hatfield Scout

~~Two~~ ~~of~~ ~~P.~~ ~~B.~~
D. W. P. B.
~~Obtain~~ ~~From~~

S-513-B

County Rice Elev. 1737
 Sec. 13 Twp. 18 Rge. 8W
 Company Shell Oil
 Farm Name E. Zajic No. 13

TOPS	DEPTH	LOG	DATUM
Anh.			
Tp.			
H.			
Tr.			
Dg.			
B.L.			
L.			
K.C.	2801		
B.K.C.			
Ce.			
C.			
M.			
M.			
K.			
Mz.			
Mq.			
V.			
S.			
S.			
A.	3201		
R.			
Pf.			
G.			
T.D.			

Loc. in Sec. _____
 SE NE NW
 (OWEB)
 Geol. D. W. P. B.
 Contr. _____
 Pool _____
 Geneseo-Edwards

FIRST REPORT
 JUN 18 78
COMPLETE

Date Comm. OTD 3217 7" @ 3202 PB 29/16
40/2864-74 1000 A P/ 11 bo 76 bw
24 hr. Comp. 1 bopd 60 bw

Co. _____
 Lse. _____
 No. _____
 Sec. _____
 T. _____
 R. _____