

Section 14 Township 18 Range 8 W

Well No. # 1 Colberg

Company Francis Raymond

NORTH

							0

SOUTH

WEST

EAST

Rice

KANSAS

8W

Sec. 14 Twp. 18 R. 8W

Well No. #1 Colberg Farm

Francis Raymond Company

Murphin - Contr Contractor


Ft. from N. Line

330' Ft. from S. Line

330' Ft. from E. Line

Ft. from W. Line

SE SE SE

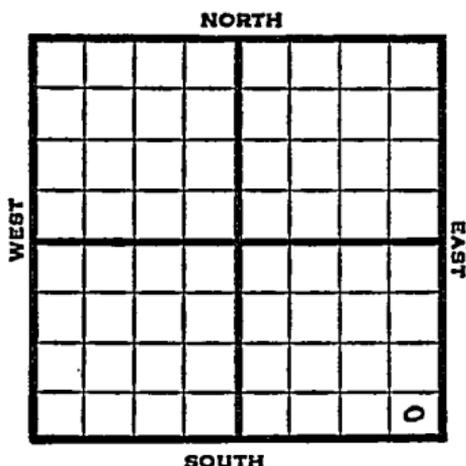

1951

Elev. 1726' REPORT

6/20

Location

7/25

Spud 6-19-51

Oil well TD 3229' 8" @ 231'

Heeb 2626' Br. lime 2750'

Lans. 2780'

DST 2995-3003' open 45 min. rec 15' mud

5' free oil Cong 3126' Arb. 3144'

TD 3152' 5" @ 3149 DD 3183'


FU 2650' oil in hole DD 3221'

FU 3000' oil DD 3229'

Comp. 3000 BOPD

COMPLETED

County Rice State Kansas
 Sec. 14 (Blk. Twp.) 18 (Sur. Rge.) 8W Map No.
 Operator Francis Raymond
 Well No. 1 Farm Colberg
 Elev. 1726 Location SE SE SE

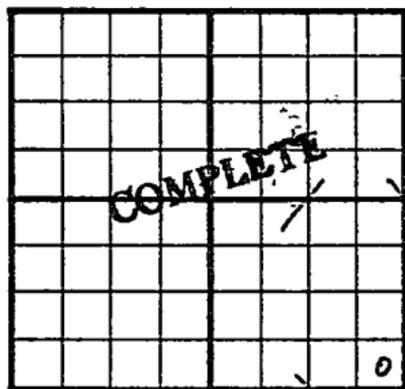

330 Ft. From S Line SE
330 Ft. From E Line Quarter
 1st. Report _____
 Completion JUL 25 1951
 Remarks _____
Murfin - Contr.
 Spudding Date 6-19-51

Drlg. Data Oil well TD 3229
8" @ 231 Heeb. 2626 Br. lime 2750
Lans. 2780 DST 2995-3003 open 45 min.
Rec. 15' mud 5' free oil Cong. 3126
Arb. 3144 TD 3152 5" @ 3149 DD 3183
FU 2650' oil in hole DD 3221 FU 3000'
oil DD 3229 Comp. 3000 bopd