


Section 14 Township 18 S Range 8 W

Well No. # 1 Willms'

Company Henry Bennett et al

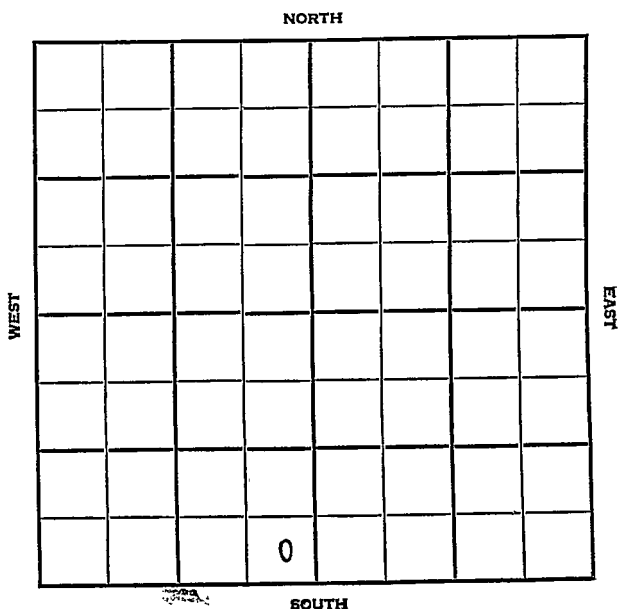

Rice

KANSAS


SEC. 14	TWP. 18S	R. 8W
------------	-------------	----------

WELL NO. #1 Willms FARM

COMPANY Henry Bennett etal

CONTRACTOR Bedell-Catt Tools.
Geneseo-Edwards.

_____ Ft. from N. Line
 330 _____ Ft. from S. Line
 330 _____ Ft. from E. Line
 _____ Ft. from W. Line

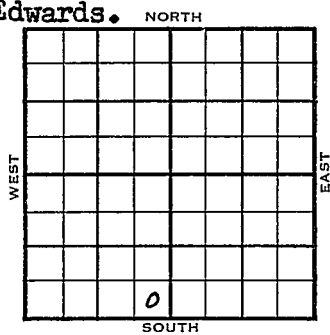

SE SE SW

1954	ELEVATION 1754'	REPORT
------	--------------------	--------

12/8 C & P
 1955
 1/5 Spud 12-25-54
 D & A
 TD 3332'
 8" @ 202'
 Top 2468' Heeb 2741', Br. Lime 2870'
 Lams 2901', BKC 3204' Cong 3288'
 TD 3332'
 D & A

ABANDONED

