


Section 14 Township 18 Range 8W

Well No. #1 Clara Willms

Company J. C. Dozier

NORTH

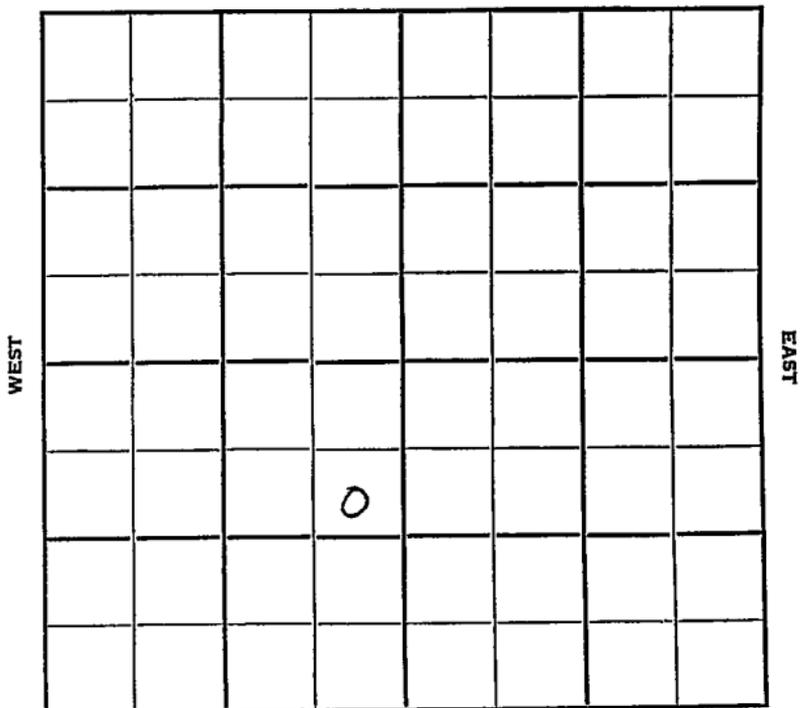

SOUTH

Rice

KANSAS

Sec. 14 Twp. 18 R. 8W ✓

Well No. #1 Clara Willms Farm

J. C. Dozier Company

Stagg Drlg. -Contr. Contractor


Geneseo Pool

990' Ft. from N. Line

\_\_\_\_\_ Ft. from S. Line

330' Ft. from E. Line

\_\_\_\_\_ Ft. from W. Line

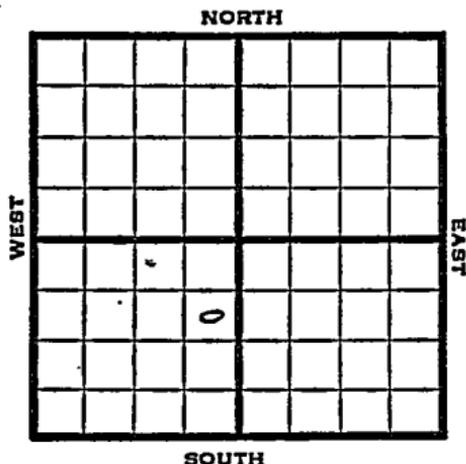

SE NE SW

1951

Elev. 1745' REPORT

6/6

Location

6/27

Spud 6-15-51

D&A TD 3284

8" @ 208

Br Lime 2840

Lans. 2867

Cong. 3218

Simp 3231-84 TD

D&A

**ABANDONED**



