



Rice

**KANSAS**

Sec. 14 Twp. 18 R. 8W

Well No. #3 Lewis Farm

Raymond & Lebow

Company

Murfin Drlg. - Contr.

Contractor

Geneseo Pool


330' Ft. from N. Line

Ft. from S. Line

990' Ft. from E. Line

Ft. from W. Line

NW NE NE

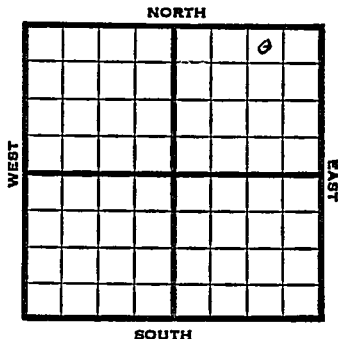

1951 Elev. 1738' REPORT

8/15 RUR

9/26 Spud 8-5-51  
Oil Well TD 3271  
8" @ 225 KC 2810 Cong. 3177  
DST 3176-95 rec. 1020' oil  
60' ocm 900' gcm 60' wtr.  
Arb. 3239-45  
5" @ 3242 TD 3271  
FU 400' wtr. 12 hr. PB 3247  
23/ 3227-35 58/ 3194-3202  
B/ 1/2 bo 1 bwph SP 3205  
24 / 3177-95 S/ 8 boph  
Comp. 225 bopd 5% wtr.

**COMPLETED**

County Rice State Kansas

Sec. 14 (Blk. Twp.) 18 (Sur. Rge.) 8W Map No.

Operator Raymond & Lebow

Well No. 3 Farm Lewis

Elev. Location NW NE NE


330 Ft. From N Line NE

990 Ft. From E Line Quarter

Ist. Report AUG 15 1951

Completion

Remarks

Murfin Drlg. - Contr.

Spudding Date

Drlg. Data Genesee Pool

R U R

Kansas

Map No. \_\_\_\_\_ Sec. 14 Twp. 18 R. 8W

Well No. 1 Lewis

Raymond & Lebow Company

~~CORRECTION~~ Contractor

NW NE NE

SECTION PLAT

330 Ft. from N. Line

\_\_\_\_\_ Ft. from S. Line

990 Ft. from E. Line

\_\_\_\_\_ Ft. from W. Line

			0

Rice County

Location \_\_\_\_\_

Rig up \_\_\_\_\_

Drilling and Remarks:

Reported

#3 Lewis

RECORD

Cased \_\_\_\_\_ in., \_\_\_\_\_ ft.

Sand \_\_\_\_\_

Gas \_\_\_\_\_

Oil \_\_\_\_\_

Total Depth \_\_\_\_\_

PRODUCTION

1st 24 hrs. Nat. \_\_\_\_\_

1st 24 hrs. after shot \_\_\_\_\_

Gas \_\_\_\_\_ Cu. Ft.

Dry Hole \_\_\_\_\_

Abandoned \_\_\_\_\_

Date

AUG 22 1951 19

J. E. TYRA

Scout

County Rice State Kansas

Sec. 14 (Blk. 18) (Sur. 8W) Map No.

Operator Raymond & Lebow

Well No. 3 Farm Lewis

Elev. 1738 Location NW NE NE

					0

330 Ft. From N Line NE

990 Ft. From E Line Quarter

Ist. Report

Completion SEP 26 1951

Remarks Geneseo Pool

Murfin Drlg. - Contr.

Spudding Date 8-5-51

Drlg. Data Oil well TD 3271

8" @ 225 KC 2810 Cong. 3177 DST 3176-

95 rec. 1020' oil 60' ocm 900' gcm

60' water Arb. 3239-45 5" @ 3242

TD 3271 FU 400' water 12 hr. PB 3247

23/ 3227-35 58/ 3194-3202 B/  $\frac{1}{2}$  bo

1 bwph SP 3205 24/ 3177-95 S/ 8 boph

Comp. 225 bopd 5% water

J. E. TYRA