

O.W.W.O.

KANSAS


FORM 51 5M 2-38 TPCO.

Rice

Section 14 Township 18 Range 8-W

Well No. #2
1-J. A. Lewis

Company Francis Raymond
Continental et al

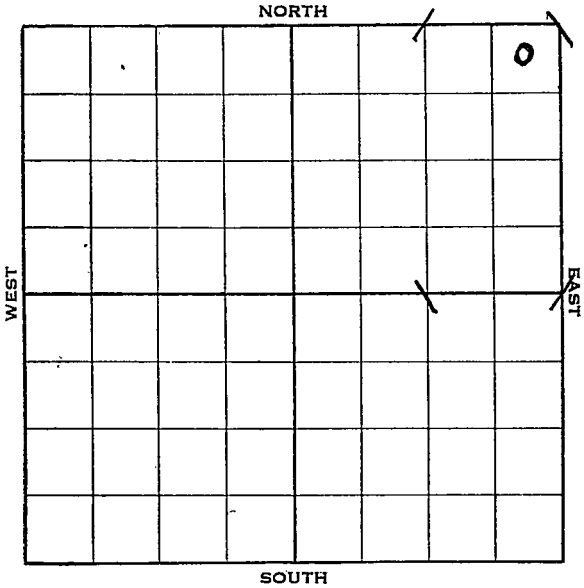

KANSAS

Rice

O.W.W.O. ✓

Sec. 14 Twp. 18 R. 8-W

Well No. #2 J. A. Lewis Farm
~~FRANCIS RAYMOND~~
~~Continental et al~~ Company

330 Ft. from N. Line


_____ Ft. from S. Line

330 Ft. from E. Line

_____ Ft. from W. Line

NE NE NE

Elev. 1747

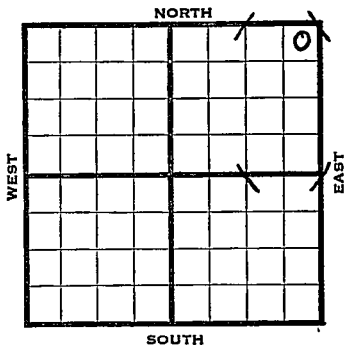

1938	REPORT
4/27	B.R.R.
5/6	10" @ 200'. WOC.
5/12	Dr lg. 2780'.
5/20	Arb. 3233-38' T.D. S.O. 7" @ 3234'. RUST.
5/27	T.D. 3242'. 3100' oil.
6/1	7" @ 3234'. Arb. 3233'. T.D. 3242'. Potential 1455 hbbls., Nat'l.
COMPLETED O.W.W.O.	
1951	
9/19	Arb. 3233' 7" @ 3234' OTD 3242' PB 3201' 48/3179-95 N/2
9/26	D & A TD 3201' Arb. 3233 7" @ 3234' OTD 3242 PB. 3201 48/3179-95 no shows D&A
ABANDONED	

Rice

KANSAS

Map No. 45 . Sec. 14 Twp. 18 R. 8W

Well No. 1 J. A. Lewis

Continental etal

Company

Contractor

FIRST REPORT

NE/C

SECTION PLAT

330 Ft. from N. Line

_____ Ft. from S. Line

330 Ft. from E. Line

_____ Ft. from W. Line

			0

Location _____

RECORD

Rig up _____

Cased _____ in., _____ ft.

Drilling and Remarks:

Sand _____

BRR

Gas _____

Oil _____

Total Depth _____

PRODUCTION

1st 24 hrs. Nat. _____

1st 24 hrs. after shot _____

Gas _____ Cu. Ft.

Dry Hole _____

Abandoned _____

Date

APR 27 1938 19

H. D. Hatfield

Scout

Rice

KANSAS

Map No. 45 Sec. 14 Twp. 18 R. 8WWell No. 1 J. A. LewisContinental etal Company

Contractor

COMPLETED
NE/C

SECTION PLAT

			0

330 Ft. from N. Line

_____ Ft. from S. Line

330 Ft. from E. Line

_____ Ft. from W. Line

Location _____

Rig up _____

Drilling and Remarks:

PT 1455NAT

RECORD

Cased 7 in., 3234 ft.Sand ATB 3233

Gas _____

Oil _____

Total Depth 3242

PRODUCTION

1st 24 hrs. Nat. _____

1st 24 hrs. after shot _____

Gas _____ Cu. Ft.

Dry Hole _____

Abandoned _____

Date

JUN 1 - 1938₁₉H. D. Hatfield Scout

County Rice State Kansas

Sec. 14 (Blk. Twp.) 18 (Sur. Rge.) 8W Map No.

Operator Francis Raymond

Well No. 2 Farm Lewis

Elev. Location NE NE NE

					0

330 Ft. From N Line NE

330 Ft. From E Line Quarter

Ist. Report SEP 19 1951

Completion

Remarks O.W.W.O.

O.W.W.O.

Spudding Date

Drlg. Data Genesee - pool

Arb 3233 7" @ 3234 OTD 3242 PB 3201

48/3179-95 N/2

J. E. TYRA

