


Rice

KANSAS  
SW

Section 14 Township \_\_\_\_\_ Range 18

Well No. #2 Willms

Company Dozier Oil Company

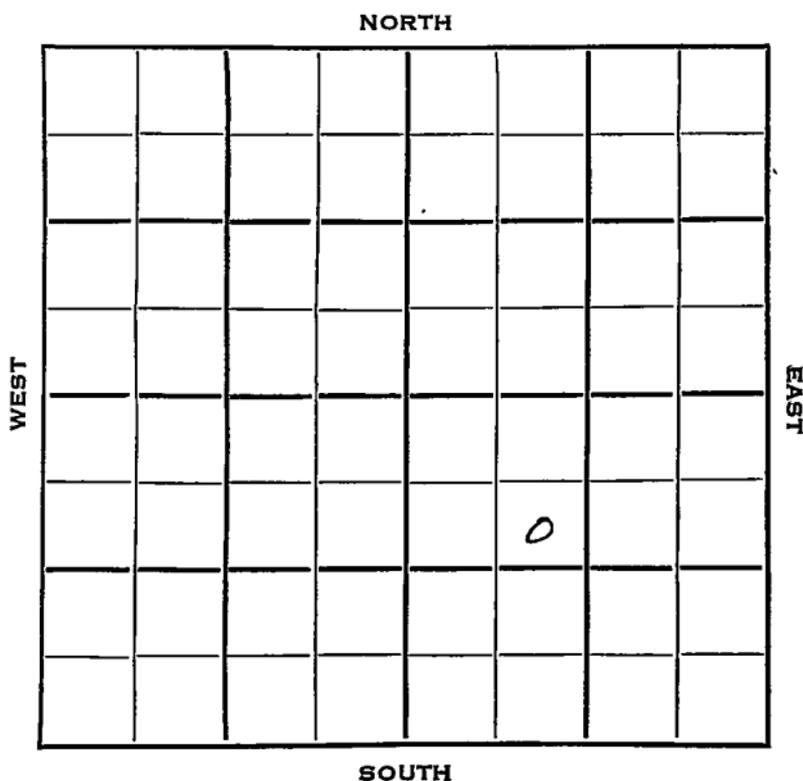

Rice

Sec. 14 Twp. 18 R. 8W

Well No. #2 Willms Farm

Dozier Oil Company Company


Stag Drlg. - Contr. Contractor

990 Ft. from N. Line

\_\_\_\_\_ Ft. from S. Line

\_\_\_\_\_ Ft. from E. Line

990 Ft. from W. Line

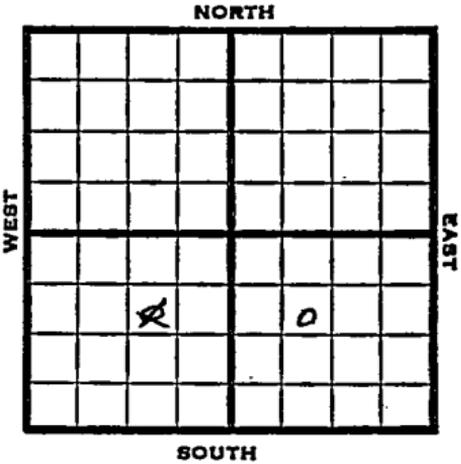

SE NW SE

1953 Elev. 1752' REPORT

3/4 Spudded 2/25/53  
8" @ 203 Drlg. 2650

3/12 Heeb 2657' Br li 2783' Lans 2813  
Cong. 3151' Arb. 3178  
RTD 3186 5" @ 3182

3/19 DD 3224' TD S/8 BOPH 8 hrs. POP

3/26 NR

4/2 NR

4/8 Spud 2-25-53  
Oil well TD 3224' 8" @ 203  
Heeb 2657' Br. lime 2783' Lans 2813  
Cong. 3151' Arb. 3178'  
TD 3186' 5" @ 3182 DD 3224  
S/8 BOPH 500 A  
Comp. 2955 BOPD 1% wtr.

**COMPLETED**



