


Section 14 Township 18 Range 8W

Well No. 3 Colberg

Company Francis Raymond

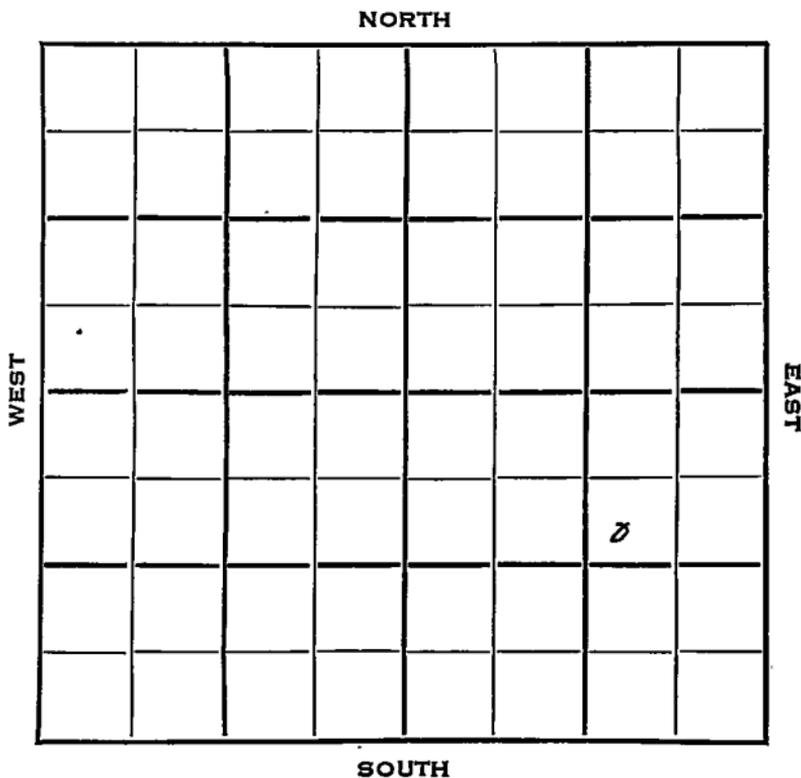

Rice

KANSAS ✓

14

18

8 W

Sec. _____ Twp. _____ R. _____

Well No. # 3 Colberg Farm _____

Francis Raymond Company _____

Uhl Drlg. Contractor _____

990

Ft. from N. Line


Ft. from S. Line

990

Ft. from E. Line

Ft. from W. Line

SW NE SE

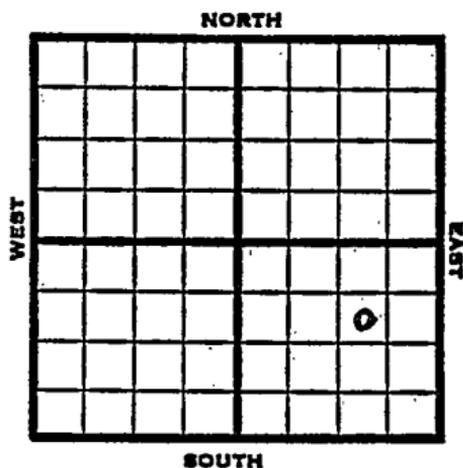

1953

Elev. 1745' REPORT

2/4

Spud 1-31-53

8" @ 244

Drlg. 250'

2/12

Heeb 2654'

Drlg. 2731'

2/19

Br li 2779 Lans 2809

DST 2826-42, 3/4 hr, 45' wtr. 450#

B KC 3112 Cong 3170 Arb 3185

RTD 3191 5" @ 3188

2/26

CO

3/12

S/50 BOPH 4 hrs.

3/18

Spud 1-31-53

Oil Well

TD 3191'

8" @ 244

Heeb' 2654, Br lime 2779, Lans

2809

DST 2826-42, opn 3/4 hrs., rec.

45' wtr., 450#

B KC 3112, Cong 3170, Arb.

3185

TD 3191

5" @ 3188

CO to 3191, S/50 boph 4 hrs.

Comp. 1749 bopd 31% wtr.

COMPLETED

