



Map No. \_\_\_\_\_ Sec. 31 Twp. 25 R. 5


Well No. 49 Robinson Farm  
Empire Company

\_\_\_\_\_ Ft. from N. Line

737 Ft. from S. Line

627 Ft. from E. Line

\_\_\_\_\_ Ft. from W. Line

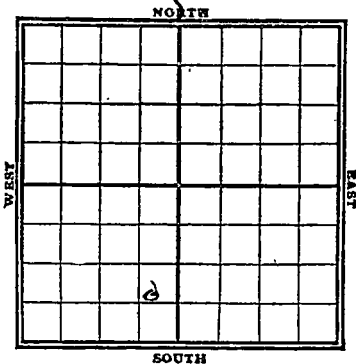

1928  
Date

REPORT

117 Jan 24 65' - 70'  
50 B.H.


Map No. K14 Sec. 31 Twp. 25 R. 5

Well No. 49 Robinson

Empire Company

Contractor

NORTH

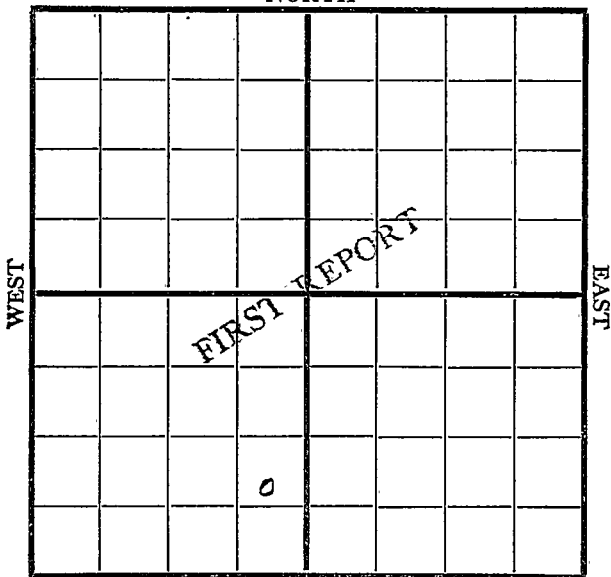

737 S

SOUTH

627 E

Location \_\_\_\_\_

Rig up  \_\_\_\_\_

Drilling and Remarks:

**RECORD**

Cased \_\_\_\_\_ in., \_\_\_\_\_ ft.

Sand \_\_\_\_\_

Gas \_\_\_\_\_

Oil \_\_\_\_\_

Total Depth \_\_\_\_\_

**PRODUCTION**

1st 24 hrs. Nat. \_\_\_\_\_

1st 24 hrs. after shot \_\_\_\_\_

Gas \_\_\_\_\_ Cu. Ft.

Dry Hole \_\_\_\_\_

Abandoned \_\_\_\_\_

Date

6/27

1919

**Pyle**

Scout

Map No. K14 Sec. 31 Twp. 25 R. 5

Well No. 49 Robinson

Empire Company

Contractor

SECTION PLAT

----- Ft. from N. Line

737 Ft. from S. Line

627 Ft. from E. Line

----- Ft. from W. Line


COMPLETED

Location -----

Rig up -----

Drilling and Remarks:

RECORD

Cased ----- in., ----- ft.

Sand 2465 - 2490

Gas -----

Oil -----

Total Depth -----

PRODUCTION

1st 24 hrs. Nat. 50 bbls

1st 24 hrs. after shot -----

Gas ----- Cu. Ft.

Dry Hole -----

Abandoned -----

Date

1/17 1920

Pyle

Scout