

# KANSAS

Butler

Section 31 Township 25 Range 5-E

Well No. #57 Robinson

Company Cities Service

Misc.

NORTH

WEST

EAST

SOUTH

Sec. 31 Twp. 25 R. 5E

Well No. 57 Robinson Farm \_\_\_\_\_

Cities Service Company  
Misc.


990 Ft. from N. Line

\_\_\_\_\_ Ft. from S. Line

990 Ft. from E. Line

\_\_\_\_\_ Ft. from W. Line

SW NE SW

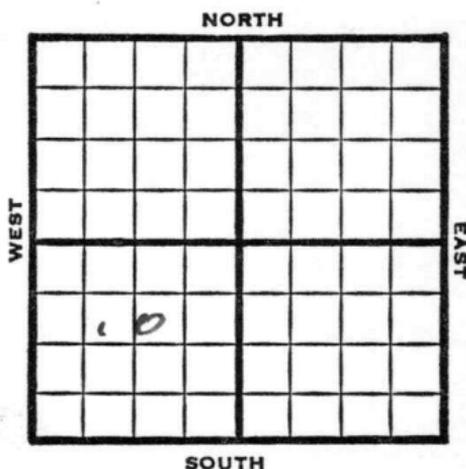

1949 Elev 1392' REPORT

7/27 Location  
8/3 8" @ 85'  
Arbuckle 2445'  
TD 2448'  
5" @ 2445'

8/10 TD 2451'  
Arb. 2445'  
5" @ 2445'  
Pump 87 Oil Pot  
38° Gr.  
Comp

**COMPLETED**

Kansas

Map No. \_\_\_\_\_ Sec. 31 Twp. 25 R. 5E

Well No. 57 Robinson

Cities Service

Company

Contractor

SW NE SW

FIRST REPORT  
SECTION PLAT

990 Ft. from N. Line

\_\_\_\_\_ Ft. from S. Line

990 Ft. from E. Line

\_\_\_\_\_ Ft. from W. Line

	6		

Butler County

Location ✓

Rig up \_\_\_\_\_

Drilling and Remarks:

RECORD

Cased \_\_\_\_\_ in., \_\_\_\_\_ ft.

Sand \_\_\_\_\_

Gas \_\_\_\_\_

Oil \_\_\_\_\_

Total Depth \_\_\_\_\_

PRODUCTION

1st 24 hrs. Nat. \_\_\_\_\_

1st 24 hrs. after shot \_\_\_\_\_

Gas \_\_\_\_\_ Cu. Ft.

Dry Hole \_\_\_\_\_

Abandoned \_\_\_\_\_

Date

JUL 27 1949 19

S. I. LEWIS

Scout

Kansas

Map No. K14 Sec. 31 Twp. 25 R. 5E

Well No. 57 Robinson

Cities Service Company

**COMPLETE**

Contractor

SW NE SW

*E 11392*

**SECTION PLAT**

990 Ft. from N. Line

\_\_\_\_\_ Ft. from S. Line

990 Ft. from E. Line

\_\_\_\_\_ Ft. from W. Line

	0		

Butler County

**RECORD**

Location \_\_\_\_\_

Cased \_\_\_\_\_ in., \_\_\_\_\_ ft.

Rig up \_\_\_\_\_

Sand \_\_\_\_\_

Drilling and Remarks:

Gas \_\_\_\_\_

Oil \_\_\_\_\_

Total Depth 2451

*Cr 2445*  
*5" Cr 2445*  
*Pump 87 oil Rod*  
*38 3/4"*

**PRODUCTION**

1st 24 hrs. Nat. \_\_\_\_\_

1st 24 hrs. after shot \_\_\_\_\_

Gas \_\_\_\_\_ Cu. Ft.

Dry Hole \_\_\_\_\_

Abandoned \_\_\_\_\_

Date

AUG 10 1949 19

S. J. LEWIS

Scout