

STATE CORPORATION COMMISSION OF KANSAS  
OIL & GAS CONSERVATION DIVISION  
WELL COMPLETION OR RECOMPLETION FORM  
ACO-1 WELL HISTORY  
DESCRIPTION OF WELL AND LEASE

Operator: License # 09408  
Name Trans Pacific Oil Corporation  
Address 410 One Main Place  
City/State/Zip Wichita, KS 67202

Purchaser KOCM OIL  
Kan

Operator Contact Person Alan D. Banta  
Phone (316) 262-3596

Contractor: License # 05841  
Name Trans Pac Drilling, Inc.

Wellsite Geologist  
Phone (316) 262-3596

Designate Type of Completion  
New Well Re-Entry Workover  
Oil SWD Temp Abd  
Gas Inj Delayed Comp.  
Dry Other (Core, Water Supply etc.)

If OWO: old well info as follows:  
Operator  
Well Name  
Comp. Date Old Total Depth

WELL HISTORY

Drilling Method:  
Mud Rotary Air Rotary Cable

10/15/88 10/22/88 10/23/88  
Spud Date Date Reached TD Completion Date  
4350'  
Total Depth PBTD

Amount of Surface Pipe Set and Cemented at 334 feet  
Multiple Stage Cementing Collar Used? Yes X No  
If yes, show depth set feet  
If alternate 2 completion, cement circulated from feet depth to w/ SX cmt  
Cement Company Name  
Invoice #

API NO. 15- 135-23,299  
County Ness  
NE SW NW 21 16S Rge. 21 East  
Sec. Twp Rge. X West

3630 Ft North from Southeast Corner of Section  
4290 Ft West from Southeast Corner of Section  
(Note: Locate well in section plat below)


Lease Name Miner Well # 1

Field Name

Producing Formation Cher. Sd.

Elevation: Ground 2350 2358  
KB

Section Plat

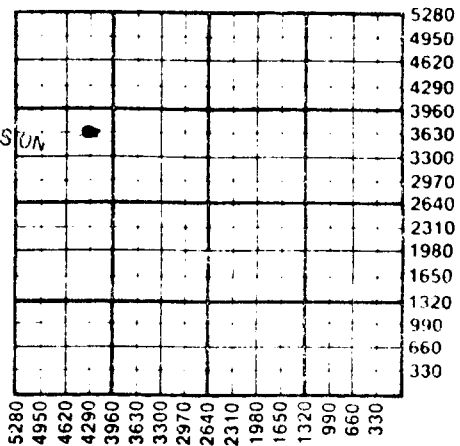

RECEIVED  
STATE CORPORATION COMMISSION  
NOV 23 1988  
CONSERVATION DIVISION  
Wichita, Kansas

WATER SUPPLY INFORMATION

Disposition of Produced Water: Disposal  
Docket # Repressuring

Questions on this portion of the ACO-1 call:

Water Resources Board (913) 296-3717

Source of Water:  
Division of Water Resources Permit #

Groundwater Ft North from Southeast Corner  
(Well) Ft West from Southeast Corner of  
Sec Twp Rge East West

Surface Water Ft North from Southeast Corner  
(Stream, pond etc) Ft West from Southeast Corner  
Sec Twp Rge East West

Other (explain)  
(purchased from city, R.W.D. #)


INSTRUCTIONS: This form shall be completed in triplicate and filed with the Kansas Corporation Commission, 200 Colorado Derby Building, Wichita, Kansas 67202, within 120 days of the spud date of any well. Rule 82-3-130, 82-3-107 and 82-3-106 apply.

Information on side two of this form will be held confidential for a period of 12 months if requested in writing and submitted with the form. See rule 82-3-107 for confidentiality in excess of 12 months. One copy of all wireline logs and drillers time log shall be attached with this form. Submit CP-4 form with all plugged wells. Submit CP-111 form with all temporarily abandoned wells.

All requirements of the statutes, rules and regulations promulgated to regulate the oil and gas industry have been fully complied with and the statements herein are complete and correct to the best of my knowledge.

Signature Alan D. Banta  
Title Exploration Manager Date 11/16/88

Subscribed and sworn to before me this 16th day of November 1988  
Notary Public Sondra J. Follis  
Date Commission Expires 11/13/1991

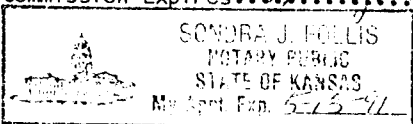

DEC 19 1988

K.C.C. OFFICE USE ONLY  
Letter of Confidentiality Attached  
Wireline Log Received  
Drillers Timelog Received  
Distribution  
KCC SWD/Rep NGPA  
KGS Plug Other (Specify)