


Section 31 Township 25 Range 5E

Well No. #59 Robinson

Company Cities Service

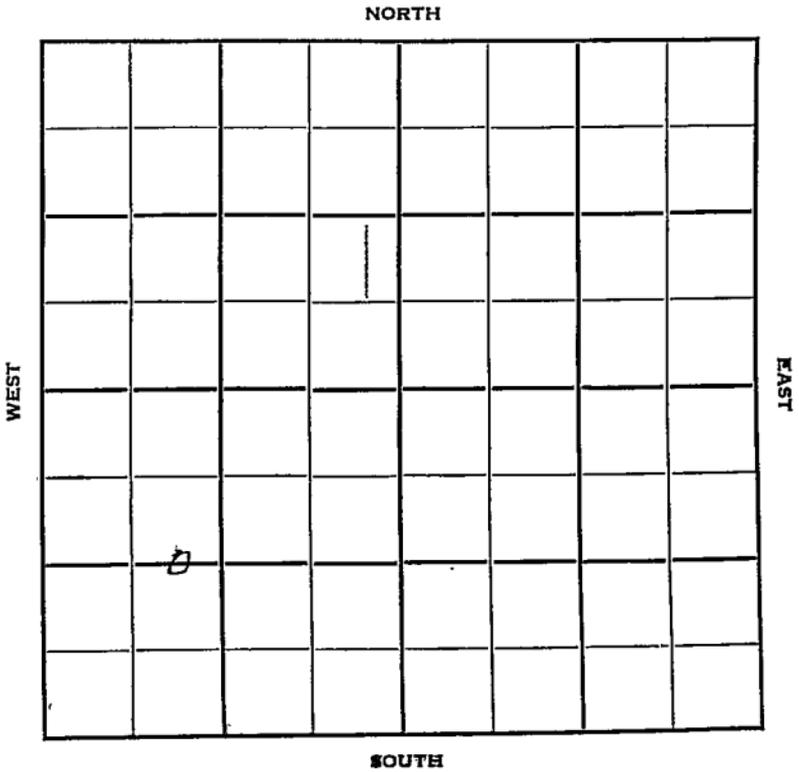

Butler

KANSAS

Sec. 31 Twp. 25 R. 5E

Well No. #59 Robinson Farm

Cities Service Company

Miscellaneous Contractor


Ft. from N. Line

1320' Ft. from S. Line

Ft. from E. Line

990' Ft. from W. Line

C E $\frac{1}{2}$ W $\frac{1}{2}$ SW

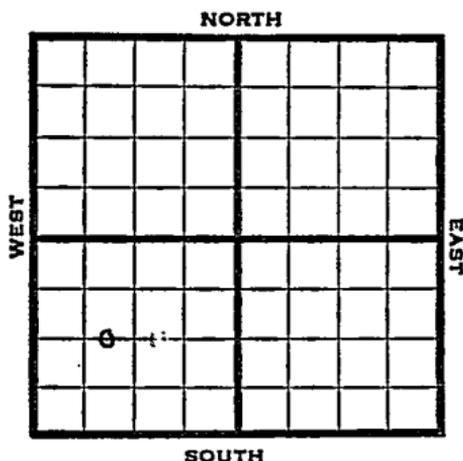

1950

Elev 1400' REPORT

4/12

8" @ 81'
Drlg. 483'

4/26

TD 2461'
8" @ 81'
Arb. 2430-34
5" @ 2431'
TD 2461'
Comp 77 BOPD
Comp

COMPLETED

Map No. _____ Sec. 31 Twp. 25 R. 5EWell No. 59 Robinson

_____ Cities Service _____ Company

_____ Contractor

C $E\frac{1}{2}$ $W\frac{1}{2}$ SW

SECTION PLAT



_____ Ft. from N. Line

1320 Ft. from S. Line

_____ Ft. from E. Line

990 Ft. from W. Line

Butler County

Location: _____

Rig up _____

Drilling and Remarks:

8" @ 81

drlg. 483

RECORD

Cased _____ in., _____ ft.

Sand _____

Gas _____

Oil _____

Total Depth _____

PRODUCTION

1st 24 hrs. Nat. _____

1st 24 hrs. after shot _____

Gas _____ Cu. Ft.

Dry Hole _____

Abandoned _____

Date

APR 12 195019J. E. TYRA Scout

Kansas

Map No. _____ Sec. 31 Twp. 25 R. 5EWell No. 59 RobinsonCities Service Company


Contractor

C $E\frac{1}{2}$ $W\frac{1}{2}$ SWE1-1400
SECTION PLAT

_____ Ft. from N. Line

1320 Ft. from S. Line

_____ Ft. from E. Line

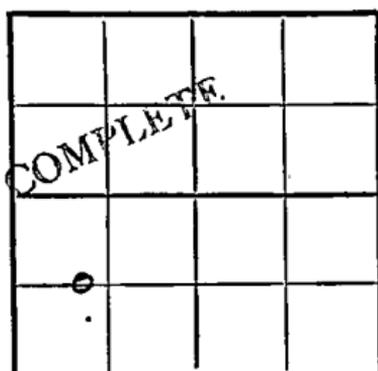990 Ft. from W. Line

Butler County

Location _____

Rig up _____

Drilling and Remarks:

8' e 81arb. 2430 - 345" c 2431T.D. 2461Comp. 77 bps

RECORD

Cased _____ in., _____ ft.

Sand _____

Gas _____

Oil _____

Total Depth 2461

PRODUCTION

1st 24 hrs. Nat. _____

1st 24 hrs. after shot _____

Gas _____ Cu. Ft.

Dry Hole _____

Abandoned _____

Date

APR 26 1950 19J. E. TYRA Scout