

Sec. 32 Twp. 25 R. 5-E

Well No. #60 Robinson Farm

Cities Service Company

Contractor

Miscellaneous


_____ Ft. from N. Line

990 Ft. from S. Line

_____ Ft. from E. Line

330 Ft. from W. Line

NW SW SW

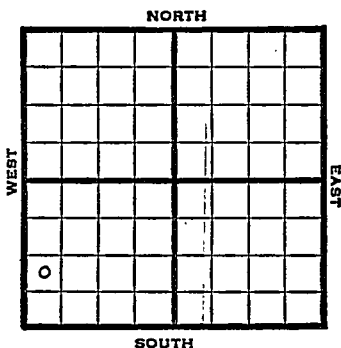

1950 Elev 1407 REPORT

9/6	8" @ 74 WOC	
10/18	8" @ 74 KC 2010 5" @ 2468 TD 2484 500 A Comp 50 bopd Completed	Arb 2469
COMPLETED		

Map No. _____ Sec. 31 Twp. 25 R. 5EWell No. 60 Robinson

Cities Service _____ Company

CORRECTION

Contractor _____

NW SW SW

SECTION PLAT

_____ Ft. from N. Line

990

_____ Ft. from S. Line

_____ Ft. from E. Line

330

_____ Ft. from W. Line

o			

Butler County

Location _____

Rig up _____

Drilling and Remarks:

Reported

32-25-5E

RECORD

Cased _____ in., _____ ft.

Sand _____

Gas _____

Oil _____

Total Depth _____

PRODUCTION

1st 24 hrs. Nat. _____

1st 24 hrs. after shot _____

Gas _____ Cu. Ft.

Dry Hole _____

Abandoned _____

Date

SEP 20 1950 19J. E. TYRA Scout

