


FORM 51

Rice

Section 14 Township 18 Range 8W

Well No. #3 Skiles

Company Dozier Oil

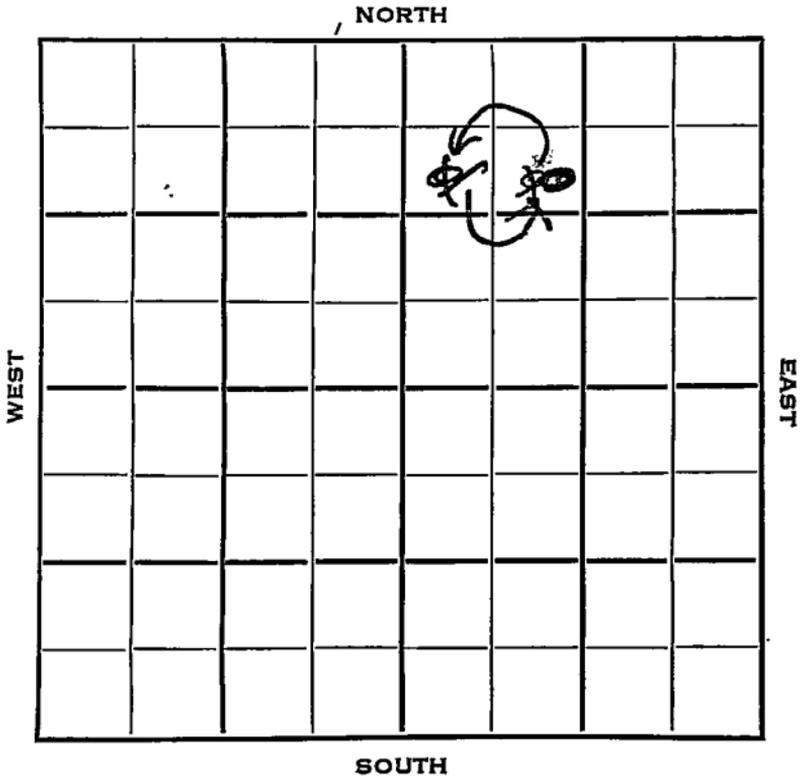

Rice KANSAS ✓

Sec. 14 Twp. 18 R. 8 W

Well No. # 3 Skiles Farm _____

Dozier Oil Company _____


Stag Drlg. Contractor _____

990 Ft. from N. Line

_____ Ft. from S. Line

_____ Ft. from E. Line

~~330~~ ~~990~~
~~990~~ Ft. from W. Line

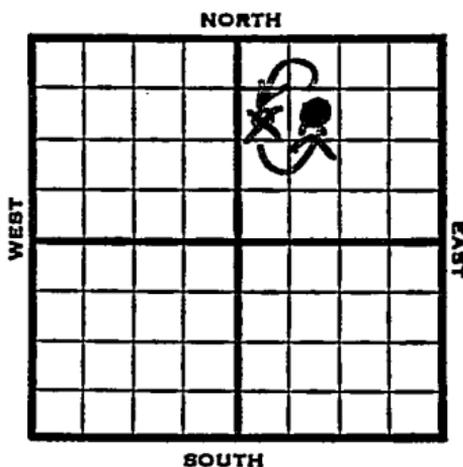

~~SE NW NE~~

~~SW NW NE~~

~~SE NW NE~~

1953 Elev. 1747' REPORT

2/11 Location

2/19 8" @ 222

2/26 Heeb 2662, Br li 2790, Lans
2818, B KC 2124, Cong 3176
Drlg. 3191

3/12 DST 3177-91, 1 hr, 240' oil & OCM
Arb. 3221' RTD 3236 5" @ 3223
DD 3259 TD 500 A

S/3 1/2 BOPH 14 hrs POP

3/18 Spud 2-15-53

Oil Well

TD 3259

8" @ 222

Heeb 2662, Br lime 2790, Lans
2818, B KC 3124, Cong 3176,

DST 3177-91, opn 1 hr., rec.
240' oil & ocm, 270#

Arb. 3221

TD 3236

5" @ 3223

DD 3259, 500A S/3 1/2 boph

Comp 95 bopd 3% wtr.

COMPLETED

County Rice State Kansas

Sec. 14 (Blk. Twp.) 18 (Sur. Rge.) 8W Map No.

Operator Dozier Oil

Well No. 3 Farm Skiles

Elev. _____ Location SE 1/4 NE

			0		

990 Ft. From N Line NE

990 Ft. From W Line Quarter

1st. Report FEB 11 1953

Completion _____

Remarks _____

Stag Drlg. - Contr.

Spudding Date _____

Drlg. Data _____

Location

J. G. McGEHEE

KAUSE

Map No. _____ Sec. 14 Twp. 18 R. 8WWell No. 3 Skiles

Dozier Oil _____ Company

CORRECTION _____ Contractor

SW NW NE

SECTION PLAT

990 Ft. from N. Line

_____ Ft. from S. Line

_____ Ft. from E. Line

330 Ft. from W. Line

		o	

Rice County

Location _____

Rig up _____

Drilling and Remarks:

Reported
SE NW NE

RECORD

Cased _____ in., _____ ft.

Sand _____

Gas _____

Oil _____

Total Depth _____

PRODUCTION

1st 24 hrs. Nat. _____

1st 24 hrs. after shot _____

Gas _____ Cu. Ft.

Dry Hole _____

Abandoned _____

Date

FEB 11 10⁰⁰ 19

J. G. McGEHEE

Scout

Map No. _____ Sec. 14 Twp. 18 R. 8W

Well No. 3 Skiles

Dozier Oil Company

CORRECTION

Contractor

SE NW NE

SECTION PLAT

990 Ft. from N. Line

_____ Ft. from S. Line

_____ Ft. from E. Line

990 Ft. from W. Line

		o	

Rice County

Location _____

Rig up _____

Drilling and Remarks:

Recorrected
from SW NW NE
CORR. S NAM

RECORD

Cased _____ in., _____ ft.

Sand _____

Gas _____

Oil _____

Total Depth _____

PRODUCTION

1st 24 hrs. Nat. _____

1st 24 hrs. after shot _____

Gas _____ Cu. Ft.

Dry Hole _____

Abandoned _____

Date

FEB 25 1953 19

J. G. MCGHEE Scout

County Rice State Kansas

Sec. 14 (Blk. Twp.) 18 (Sur. Rge.) 8W Map No.

Operator Dozier Oil

Well No. 3 Farm Skiles

Elev. 1747 Location SE NW NE

990 Ft. From N Line NE

990 Ft. From W Line Quarter

Ist. Report

Completion MAR 18 1953

Remarks

Stag Drlg. - Contr.

Spudding Date 2-15-53

Drlg. Data Oil well TD 3259

8" @ 222 Heeb. 2662 Br. lime 2790

Lans. 2818 B KC 3124 Cong. 3176

DST 3177-91 open 1 hr. Rec. 240' oil

& ocm 270# Arb. 3221 TD 3236

5" @ 3223 DD 3259 500 A S/ 3 1/2 boph

Comp. 95 bopd 3% wtr.