


Rice

SECTION 14 TOWNSHIP 18 RANGE 8 W

WELL NO. #1 Skiles

COMPANY Chet Williams

NORTH

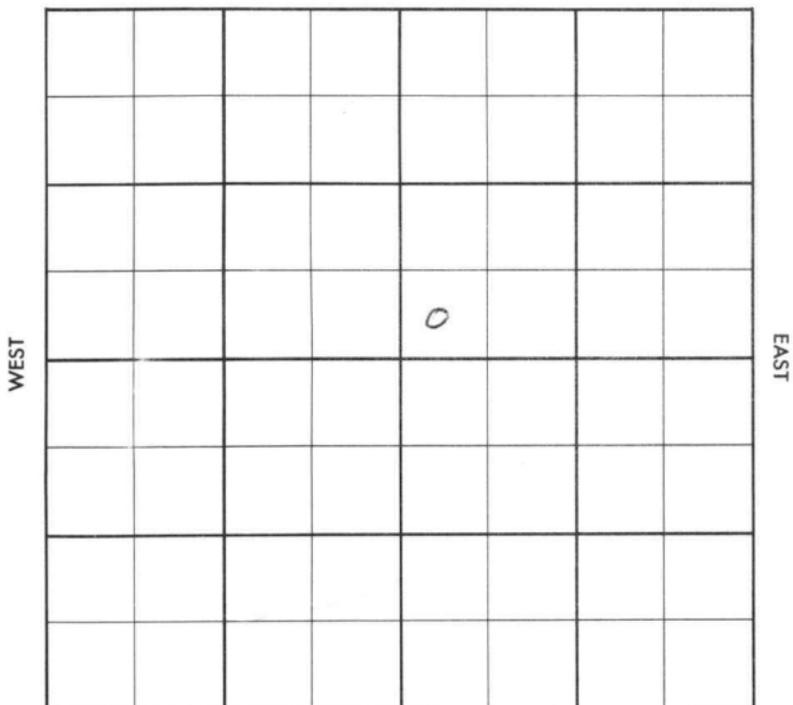

SOUTH

Rice

KANSAS

SEC. 14	TWP. 18	R. 8W
------------	------------	----------

WELL NO. #4 Skiles FARM

COMPANY Chet Williams

CONTRACTOR Lewis


Geneseo-Edward

_____ Ft. from N. Line

_____ Ft. from S. Line

_____ Ft. from E. Line

_____ Ft. from W. Line

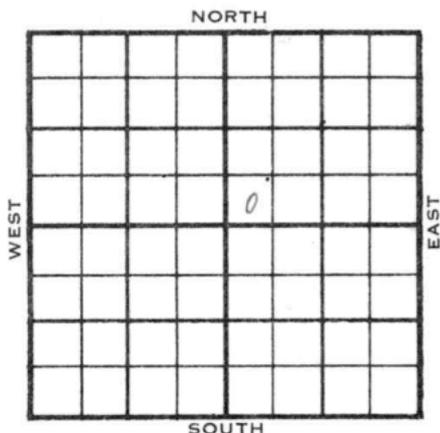

SW SW NE

1956	ELEVATION REPORT
1-18	RUR

County Rice Elev. _____
 Sec. 11 Twp. 18 Rge. 8W
 Company Chet Williams
 Farm Name Skiles No. 4

TOPS	DEPTH	LOG	DATUM
Anh.			
Tr.			
H.			
Tr.			
Dg.			
B.L.			
L.			
K.C.			
B.K.C.			
Ce.			
C.			
M.			
M.			
K.			
Mz.			
Me.			
V.			
S.			
S.			
A			
R.			
PE			
G.			
T.D.			

Loc. in Sec. SW SW NE
 Geol. _____
 Contr. Lewis
 Pool Geneseo-Edward

FIRST REPORT
 0
 JAN 18 '58

Date Comm.

RUR

[Handwritten signature]

Co.
 Lse.
 No.
 Sec.
 T.
 R.

County Rice Elev. 1751
 Sec. 14 Twp. 18 Rgn. 8W
 Company Chet Williams
 Form Name Skiles No. 4

TOPS	DEPTH	LOG	DATUM	Loc. in Sec.
Ant.				SW SW NE
Tp.				2350 NL
H.	2676			450 WL
Tr.	2697			
Sp. <u>sd</u>	2723		972	
Bl.				
L.	2836		1085	Geol.
LC				Cont.
REL	3120		1369	
Co.				Lewis
C.	3183		1432	
M.				Pool
N.				Geneseo-Edward
K.				
Ma.				
Mo.				
V.				
S.				
S.				
A.	3236		1475	
R.	3572		1821	
Pr. Rec. ch.	3613		1864	
Q.				
TR	3825			

FEB 29 1956

Date Comm.

RUR JAN 25 '56 1-18-56 DST 260
 1156 3020 FEB 1 '56 DST 3228
 -54 90" see 15' WM BHP 4#
 5/2 3772 / FEB 8 '56 ✓ FEB 15 '56 ✓
 FEB 22 '56 ✓ FEB 29 '56 ✓ ca 3825 TP
 19 complete

SWD