


Map No. _____ Sec 21 Twp 25 R 5Well No. 70 Robinson Farm __________ Lucas Company

NORTH

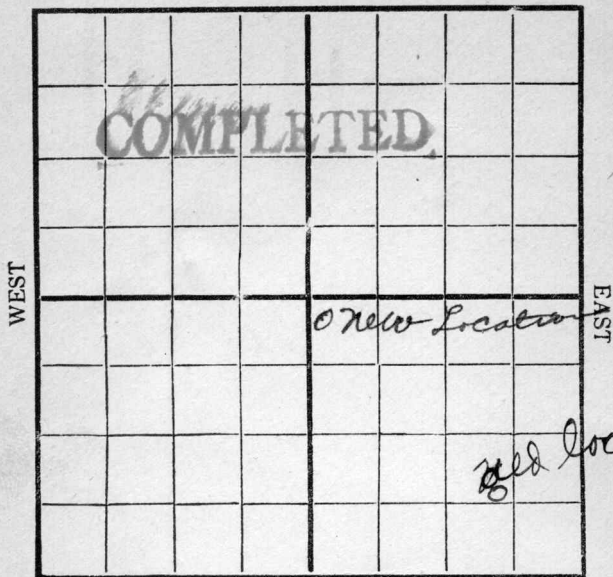

SOUTH

Location _____

Rig Up _____

Drilling Remarks:

Drilling Remarks:

RECORD

PRODUCTION

Cased _____ in _____ Ft.

1st 24 hrs. Nat _____

Sand _____

1st 24 hrs. after shot _____

Gas _____

Gas _____ Cu. Ft.

Oil _____


Dry Hole _____

Total Depth _____

Abandoned _____

Map No. _____ Sec. 31 Twp. 25 R. 5
 Well No. 70 Robinson Farm _____
Sinclair Company _____

NORTH

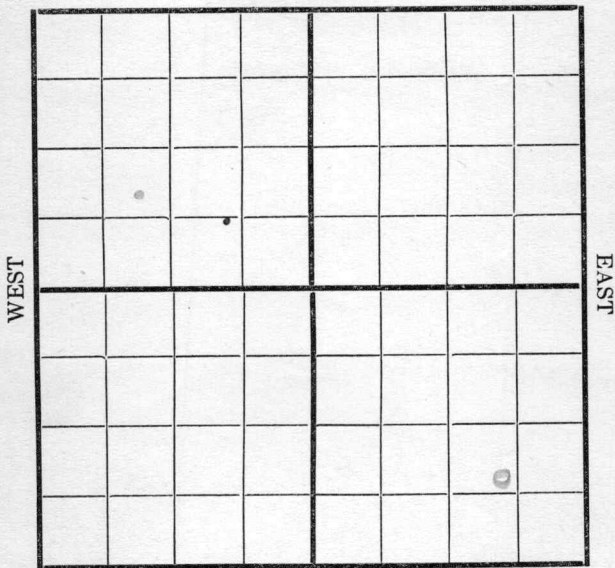

SOUTH

Location _____
 Rig Up ☒ _____
 Drilling and remarks _____

FIRST REPORT

RECORD

Cased _____ in. _____ Ft.
 Sand _____
 Gas _____
 Oil _____
 Total Depth _____

PRODUCTION


1st 24 hrs. Nat. _____
 1st 24 hrs. after shot _____
 Gas _____ Cu. Ft.
 Dry Hole _____
 Abandoned _____

Date

3/21, 1917 Carley Scout

Map No. _____ Sec. 31 Twp. 35 R. 5
Well No. 7.0 Robinson Farm _____
Sinaloa Company _____

NORTH

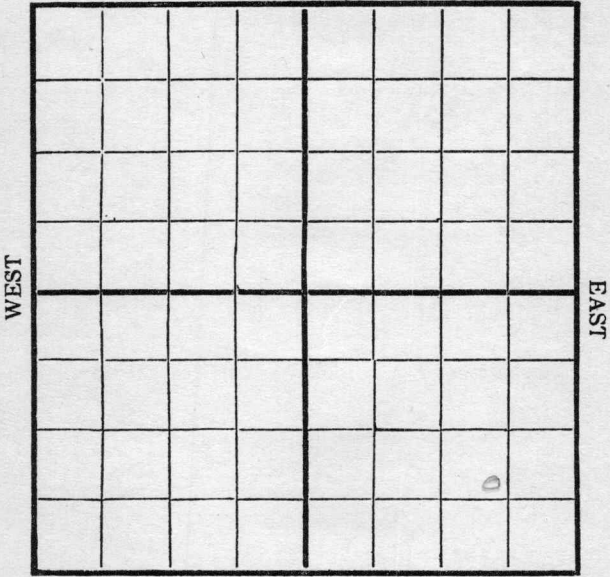

SOUTH

Location _____
Rig Up _____
Drilling and remarks _____

RECORD

Cased _____ in. _____ Ft.
Sand _____
Gas _____
Oil _____
Total Depth _____


PRODUCTION

1st 24 hrs. Nat. _____
1st 24 hrs. after shot _____
Gas _____ Cu. Ft.
Dry Hole _____
Abandoned _____

Date 3/26, 1917 C. C. Coffey Scout

Map No. _____ Sec. 31 Twp. 25 R. 5Well No. 70 Robinson FarmSun Oil Company

NORTH

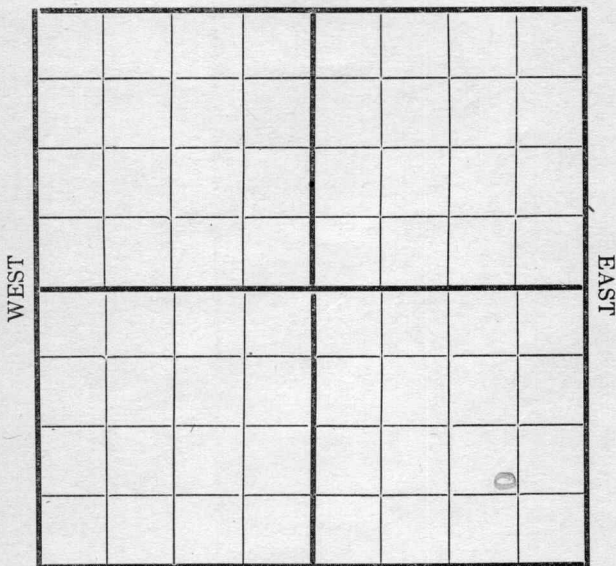

SOUTH

Location _____

Rig Up ☒ _____

Drilling and remarks _____

RECORD

Cased _____ in. _____ Ft.

Sand _____

Gas _____

Oil _____

Total Depth _____

PRODUCTION

1st 24 hrs. Nat. _____

1st 24 hrs. after shot _____

Gas _____ Cu. Ft.

Dry Hole _____


Abandoned _____

Date

4/5, 1917 C. Condy Scout

Map No. _____ Sec. 31 Twp. 25 R. 5
Well No. 20 Robinson Farm _____
Swain Company _____

NORTH

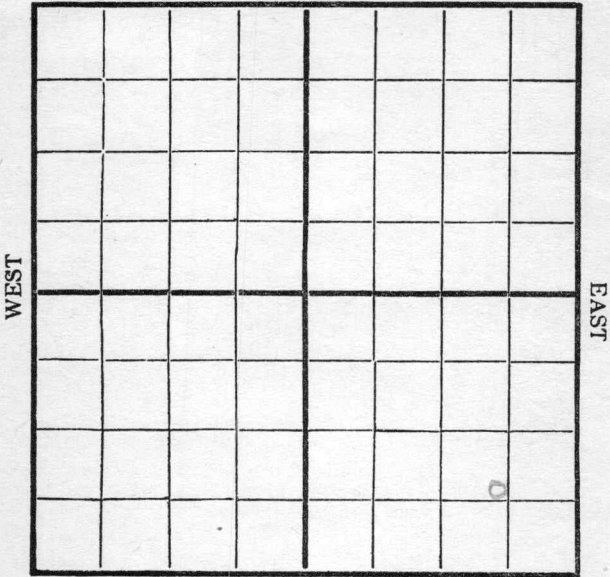

SOUTH

Location _____ Rig Up _____ Drilling and remarks _____	RECORD
	Cased _____ in. _____ Ft.
	Sand _____
	Gas _____
	Oil _____
	Total Depth _____
	PRODUCTION
	1st 24 hrs. Nat. _____
	1st 24 hrs. after shot _____
	Gas _____ Cu. Ft.
	Dry Hole _____
	Abandoned _____


Date 4/11, 1917 Co. J. J. J. Scout _____

Map No. _____ Sec. 31 Twp. 25 R. 5
 Well No. 70 Robinson Farm
Shiloh Company

NORTH

WEST

EAST

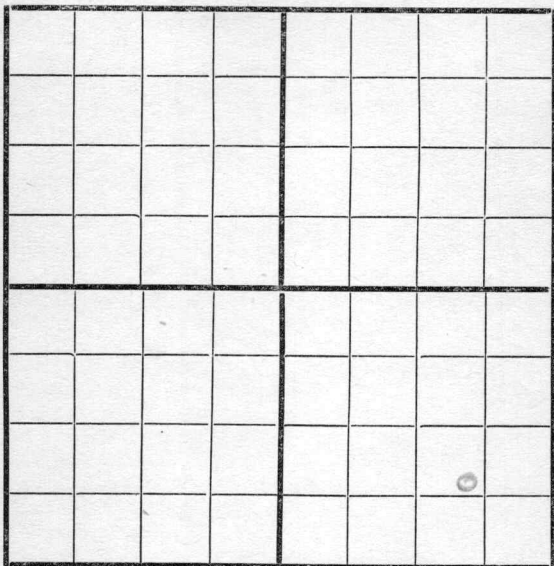

SOUTH

Location _____
 Rig Up ☒ _____
 Drilling and remarks _____

RECORD

Cased _____ in. _____ Ft.
 Sand _____
 Gas _____
 Oil _____
 Total Depth _____


PRODUCTION

1st 24 hrs. Nat. _____
 1st 24 hrs. after shot _____
 Gas _____ Cu. Ft.
 Dry Hole _____
 Abandoned _____

Date 4/19, 1917 Carly Scout

Map No. _____ Sec. 31 Twp. 25 R. 5Well No. 70 Robinson FarmSmolin Company

NORTH

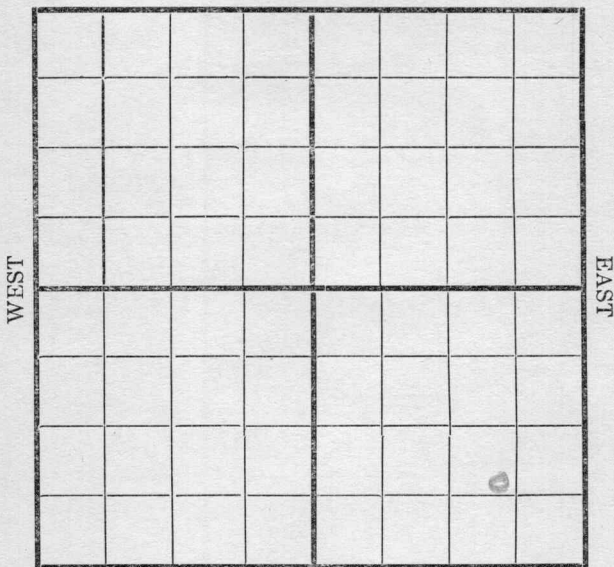

SOUTH

Location _____

Rig Up ☒ _____

Drilling and remarks _____

RECORD

Cased _____ in. _____ Ft.

Sand _____

Gas _____

Oil _____

Total Depth _____

PRODUCTION

1st 24 hrs. Nat. _____

1st 24 hrs. after shot _____

Gas _____ Cu. Ft.

Dry Hole _____

Abandoned _____

Date

APR 26 1917


191

C. S. S.

Scout

Map No. _____ Sec. 31 Twp. 25 R. 5
 Well No. 70 Robinson Farm _____
Sinclair Company _____

NORTH

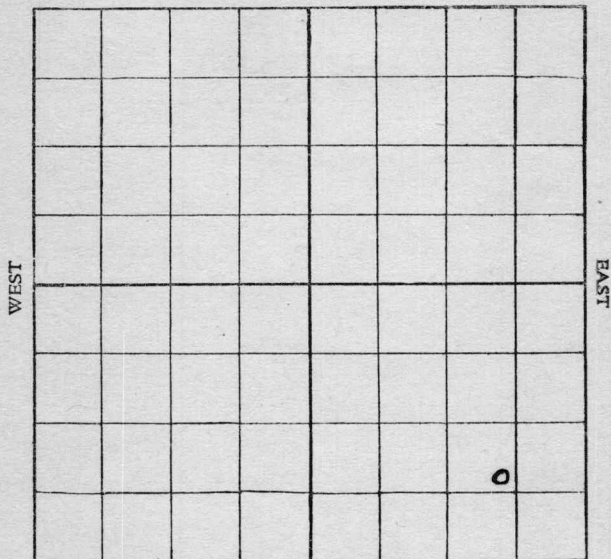

SOUTH

Location _____

Rig up _____

Drilling and remarks:

Rig

RECORD

Cased _____ in. _____ Ft.

Sand _____

Gas _____

Oil _____

Total Depth _____

PRODUCTION

1st 24 hrs. Nat. _____

1st 24 hrs. after shot _____

Gas _____ Cu. Ft.

Dry Hole _____

Abandoned _____

Date


5/5, 1917, Drocker Scout

Map No. _____ Sec. 31 Twp. 25 R. 5

Well No. 70 Robinson Farm

Sinclair Company

NORTH

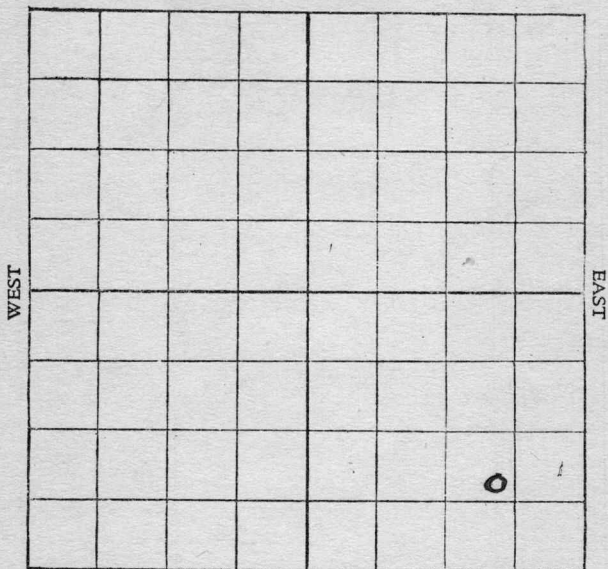

SOUTH

Location _____

• Rig up _____

Drilling and remarks:

Rig.

RECORD

Cased _____ in. _____ Ft.

Sand _____

Gas _____

Oil _____

Total Depth _____

PRODUCTION

1st 24 hrs. Nat. _____

1st 24 hrs. after shot _____

Gas _____ Cu. Ft.


Dry Hole _____

Abandoned _____

Date

5/12, 1917, 7 Crocker Scout

Map No. _____ Sec. 31 Twp. 25 R. 5
 Well No. 70 Robinson Farm _____
Sinclair Company _____
 NORTH

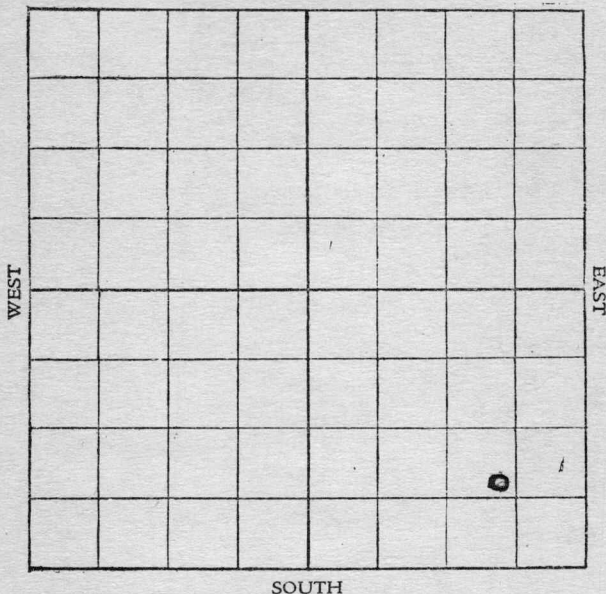

Location _____

Rig up _____

Drilling and remarks:

Rign up

RECORD

Cased _____ in. _____ Ft.

Sand _____

Gas _____

Oil _____

Total Depth _____

PRODUCTION

1st 24 hrs. Nat. _____

1st 24 hrs. after shot _____

Gas _____ Cu. Ft.

Dry Hole _____


Abandoned _____

Date

5/19, 1917, Crocker Scout

Map No. _____ Sec. 31 Twp. 25 R. 5Well No. 70 Robinson Farm
Sinclair Company

NORTH

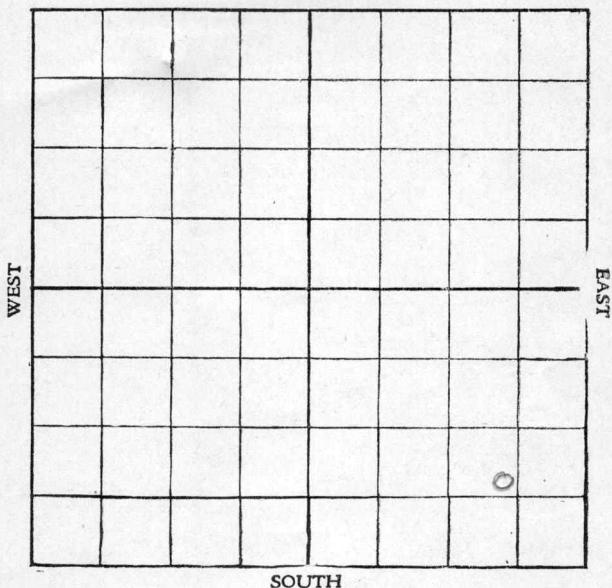

SOUTH

Location _____

Rig up _____

Drilling and remarks:

Rig up.

RECORD

Cased _____ in. _____ Ft.

Sand _____

Gas _____

Oil _____

Total Depth _____

PRODUCTION

1st 24 hrs. Nat. _____

1st 24 hrs. after shot _____

Gas _____ Cu. Ft.


Dry Hole _____

Abandoned _____

Date

5/26/1917, Brocker Scout

Map No. _____ Sec. 31 Twp. 25 R. 5
 Well No. 70 Robinson Farm
Sinclair Company

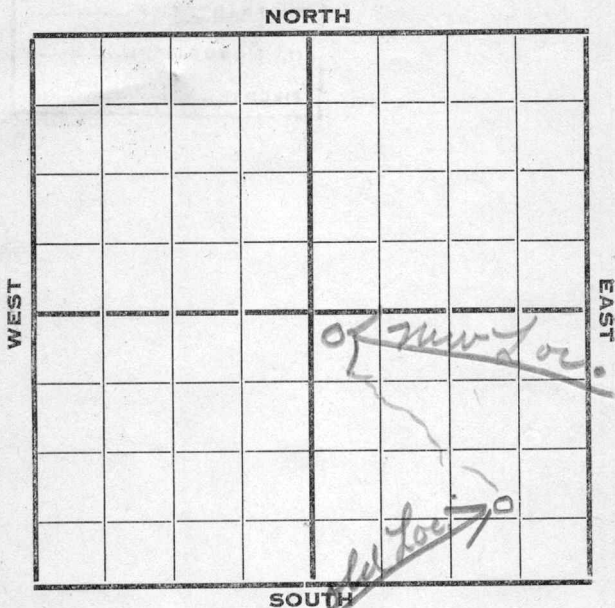

Location _____

Rig up _____

Drilling and Remarks:

Moved Loc.
to N.W. Cor of
S.E. 1/4

RECORD

Cased _____ in. _____ Ft.

Sand _____

Gas _____

Oil _____

Total Depth _____

PRODUCTION

1st 24 hrs. Nat. _____

1st 24 hrs. after shot _____

Gas _____ Cu. Ft.

Dry Hole _____


Abandoned _____

Date

6/2, 1917 C. J. Crocker Scout

Map No. _____ Sec. 31 Twp. 25 R. 5
 Well No. 70 Robinson Farm _____
Sinclair Company

NORTH

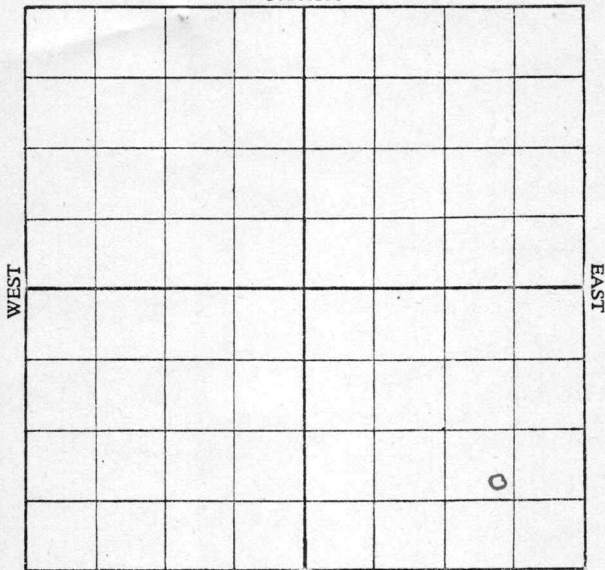

SOUTH

Location _____

Rig up _____

Drilling and remarks:

D-525'

RECORD

Cased _____ in. _____ Ft.

Sand _____

Gas _____

Oil _____

Total Depth _____

PRODUCTION

1st 24 hrs. Nat. _____

1st 24 hrs. after shot _____

Gas _____ Cu. Ft.

Dry Hole _____

Abandoned _____

Date

JUN 16 1917

G. I. Crocker


_____, 191_____, _____ Scout

Map No. _____ Sec. 31 Twp. 25 R. 5
 Well No. 70 Robinson Farm
Sincclair Company

NORTH

WEST

EAST

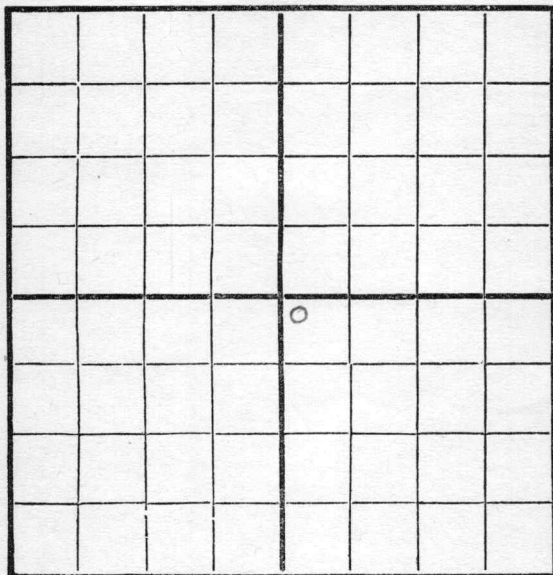

SOUTH

Location _____
 Rig Up _____
 Drilling and remarks _____

RECORD

Cased _____ in. _____ Ft.
 Sand _____
 Gas _____
 Oil _____
 Total Depth _____

PRODUCTION

1st 24 hrs. Nat. _____
 First 24 hrs. after shot _____
 Gas _____ Cu. Ft.
 Dry Hole _____
 Abandoned _____

Date

JUN 22 1911

191

E. J. Crocker
 Scout

Map No. L-1003 K-14 Sec. 31 Twp. 25 R. 5

Well No. 70 Robinson Farm

E. Ink. Company

NORTH



SOUTH

Location N.W.

Rig up

Drilling and remarks:

Spud

RECORD

Cased _____ in. _____ Ft.

Sand _____

Gas _____

Oil _____

Total Depth _____

PRODUCTION

1st 24 hrs. Nat. _____

1st 24 hrs. after shot _____

Gas _____ Cu. Ft.

Dry Hole _____

Abandoned _____


Date

JUN 9 1911

, 1911, E. T. Crocker Scout

Map No. _____ Sec. 31 Twp. 25 R. 5
 Well No. 70 Robinson Farm _____
 _____ Empire Company

NORTH

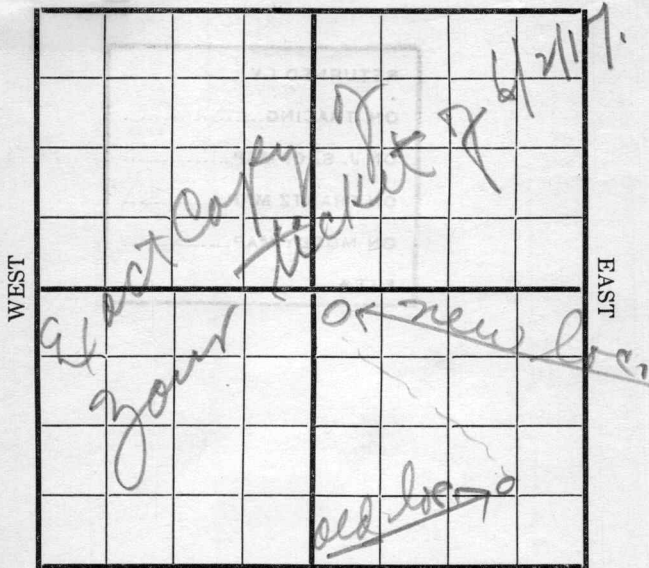

SOUTH

Location _____
 Rig Up _____
 Drilling and remarks _____

*moved loc.
 to N.W. Cor of
 S.E. 1/4*

RECORD

Cased _____ in. _____ Ft.
 Sand _____
 Gas _____
 Oil _____
 Total Depth _____


PRODUCTION

1st 24 hrs. Nat. _____
 1st 24 hrs. after shot _____
 Gas _____ Cu. Ft.
 Dry Hole _____
 Abandoned _____

Date 6/2, 1917 _____ Scout _____

Map No. _____ Sec. 31 Twp. 25 R. 5
 Well No. 70 Robinson Farm _____
Sinclair Company _____

NORTH

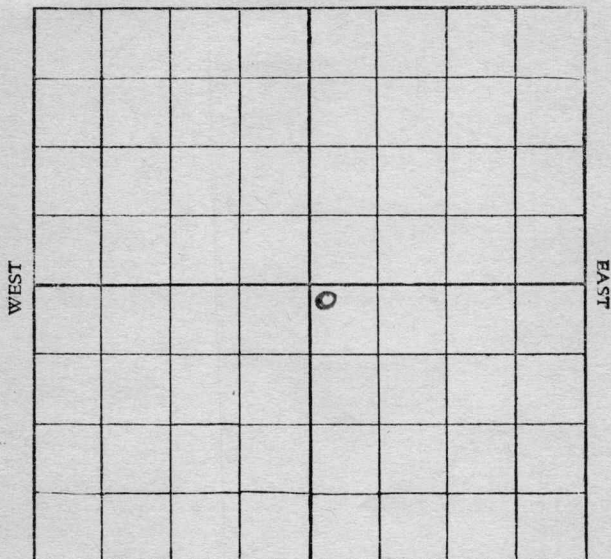

SOUTH

Location _____

Rig up _____

Drilling and remarks:

B-1300

RECORD

Cased _____ in. _____ Ft.

Sand _____

Gas _____

Oil _____

Total Depth _____

PRODUCTION

1st 24 hrs. Nat. _____

1st 24 hrs. after shot _____

Gas _____ Cu. Ft.

Dry Hole _____

Abandoned _____

Date JUN 3 0 1917

, 191


C. T. Crocker Scout

Map No. _____ Sec. 31 Twp. 25 R. 5

Well No. 70 Robinson Farm

Sinclair Company

NORTH

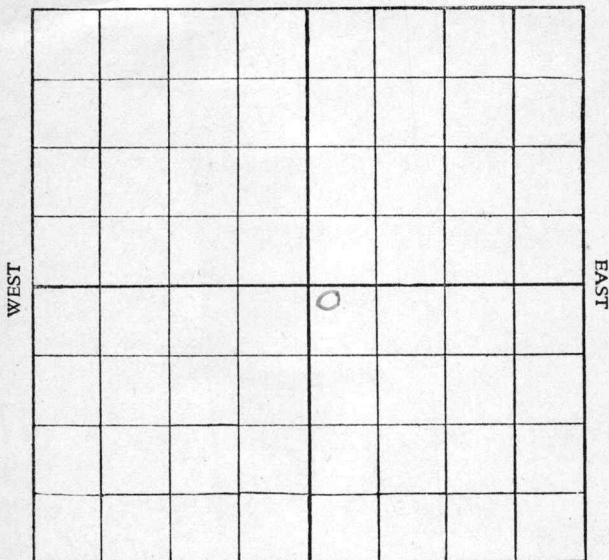

SOUTH

Location _____

Rig up _____

Drilling and remarks:

D-1580'

RECORD

Cased _____ in. _____ Ft.

Sand _____

Gas _____

Oil _____

Total Depth _____

PRODUCTION

1st 24 hrs. Nat. _____

1st 24 hrs. after shot _____

Gas _____ Cu. Ft.

Dry Hole _____

Abandoned _____

Date JUL 7 1917

G. V. Crocker

, 191

Scout

Map No. _____ Sec. 31 Twp. 25 R. 5Well No. 78 Robinson FarmLincoln Company

NORTH

				O			

SOUTH

Location _____

Rig up _____

Drilling and remarks:

1875 St.
rearing

RECORD

Cased _____ in. _____ Ft.

Sand _____

Gas _____

Oil _____

Total Depth _____

PRODUCTION

1st 24 hrs. Nat. _____

1st 24 hrs. after shot _____

Gas _____ Cu. Ft.

Dry Hole _____

Abandoned _____

Date


JUL 14 1917

G. T. Crocker
Scout

Map No. _____ Sec. 31 Twp. 25 R. 5Well No. 70 Robinson FarmSnichor Company

NORTH

WEST

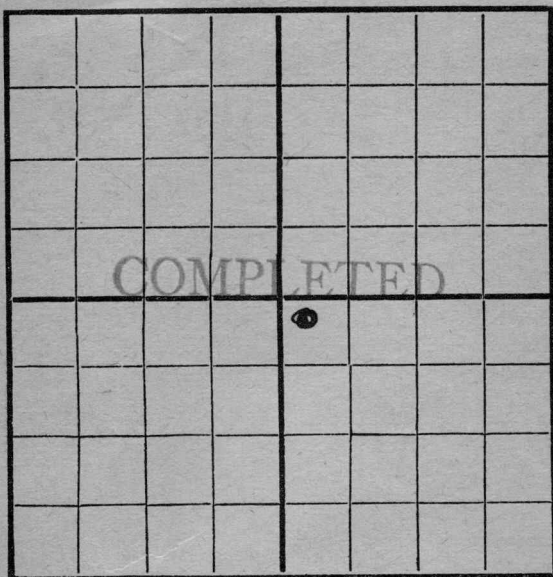

EAST

SOUTH

○ Location _____

Rig Up _____

Drilling and remarks

Est at100 Bbl

RECORD

Cased _____ in. _____ Ft.

Sand 2459-2469

Gas _____

Oil _____

Total Depth _____

PRODUCTION

1st 24 hrs. Nat. _____

1st 24 hrs. after shot _____

Gas _____ Cu. Ft.

Dry Hole _____

Abandoned _____

Date

8/1

191

7 Condy

Scout