

Section 14 Township 18 Range 8 W

Well No. # 4 Colberg

Company Francis Raymond

NORTH

							0

WEST

EAST

SOUTH

Sec. 14 Twp. 18 R. 8W

Well No. #4 Colberg Farm

Francis Raymond Company

Flourney Contractor


330 Ft. from N. Line

Ft. from S. Line

330 Ft. from E. Line

Ft. from W. Line

NE NE SE

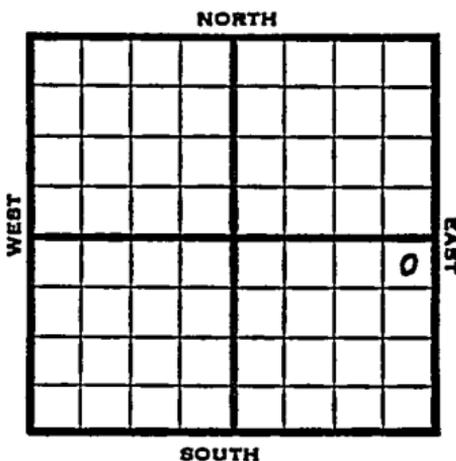

1953 Elev. 1737' REPORT

4/15 Spud 4-10-53
8" @ 218
Anhy 290
Drlg. 1600'

4/23 Heeb 2666 Br li. 2796 Lans 2826
Cong 3171
DST 3211-20, 1 hr, 100' M & W 650#
Arb. 3250
DST 3250-53, 3/4 hr, 1000' gas, 60'
HOCM, 50' GCO 900# RTD 3253
5" @ 3251
CO 3253' S/8 BOPH 4 hrs.

4/30 5/7 NR

5/20 Spud 4-10-53
Oil Well
TD 3253
8" @ 218
Anhy 290, Heeb 2666, Br lime 2796,
Lans 2826, Cong 3171
DST 3211-20, opn 1 hr., rec. 100' mud,
& wtr - 650#
Arb. 3250
DST 3250-53, opn 3/4 hrs., rec. 1000'
gas, 60' hocm, 50' gco, 900#
TD 3253
5" @ 3251
CO to 3253, S/8 boph 4 hrs.
Comp. 35 bopd 18% wtr. **COMPLETED**

