


Map No. **KANSAS** Sec. 17 Twp. 18 R. Rice
 Well No. 5- Buckler Farm 8W
Three Rivers Oil Company

NORTH

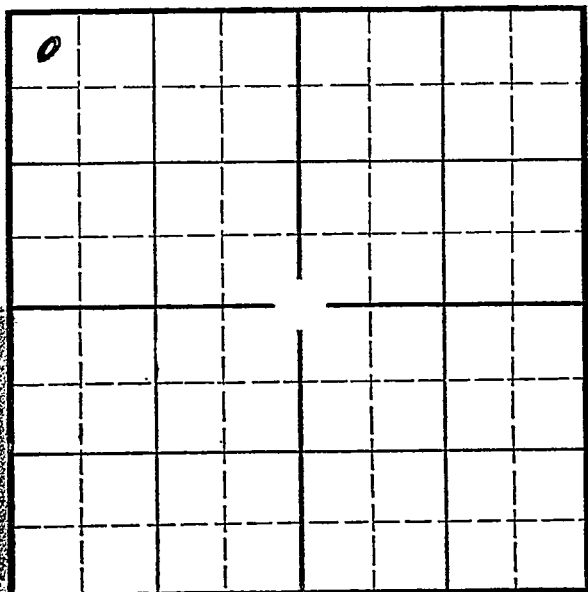

SOUTH

Location _____

Drilling Remarks _____

Rig Up _____

Drilling Remarks _____

RECORD

Cased _____ in. _____ ft.

Sand _____

Gas _____

Oil _____

Total Depth _____

PRODUCTION

1st 24 hrs. Nat. _____

1st 24 hrs. after shot _____

Gas _____ cu. ft. _____

Dry Hole _____

Abandoned _____

5M 7-34 MPC
Map No. KANSAS S

Map No. 11 Sec. 11 Twp. 10 R. 0

Well No. 1- Buckler Farm

1- Buckler
Three Rivers Oil

NORTH

330 Ft. from N. Line

Ft. from S. Line

Ft. from E. Line

330 Ft. from W. Line

Test

FAQ

SOUTH

Elev. 1748

Date _____

REPORT

6/19 Bldg Rig
6/28

7/31	R 22
------	------

17/11 dlog 395 10" 380

7/8	"V	1660
-----	----	------

8/4 1FW 2440-50 T7 2468

8/8 Del 2790

8/15 KVC 2895 to 2913
2913 to 2915 1500 9007

27 2910 17F 00 6101
18" 2007


345'6" River

1	3242
---	------

8/29 8th 3/88 Co 3255

8" 3259 Nil 3425

HFV 343.

9/12 Kil 3425

77343

Q. A.

~~ABANDONED~~

Map No. 45 Sec. 17 Twp. 18 R. 8W

Well No. 1- Buckler

Three River oil Company

Contractor

FIRST REPORTS

SECTION PLAT

330 Ft. from N. Line

..... Ft. from S. Line

..... Ft. from E. Line

330 Ft. from W. Line

0			



Special

Location.....

Rig up.....

Drilling and Remarks:

Bed of Rig

RECORD

Cased.....in.,ft.

Sand.....

Gas.....

Oil.....

Total Depth.....

PRODUCTION

1st 24 hrs. Nat.....

1st 24 hrs. after shot.....

Gas.....Cu. Ft.

Dry Hole.....

Abandoned.....

Date

6-19-35 192.....

W. H. B. B. B.

Scout

KANSAS

Map No. 45 Sec. 17 Twp. 18 R. 8^NWell No. 1- BucklerThree River Oil Company

Contractor

ABANDONED

SECTION PLAT

330 Ft. from N. Line

Ft. from S. Line

Ft. from E. Line

330 Ft. from W. Line

0			

Location

Rig up

Drilling and Remarks:

O & A.

RECORD

Cased in. ft.

Sand oil 3425

Gas

Oil

Total Depth 3435

PRODUCTION

1st 24 hrs. Nat.

1st 24 hrs. after shot

Gas Cu. Ft.

Dry Hole

Abandoned

Date

ORVAL MANNSCHRECK

9-17-35 192

Scout