
FORM 51 25M 8-50 WESTERN

Rice KANSAS

Section 18 Township 18 Range 8W

Well No. #1 Seimsen

Company Howard Hogan - et al

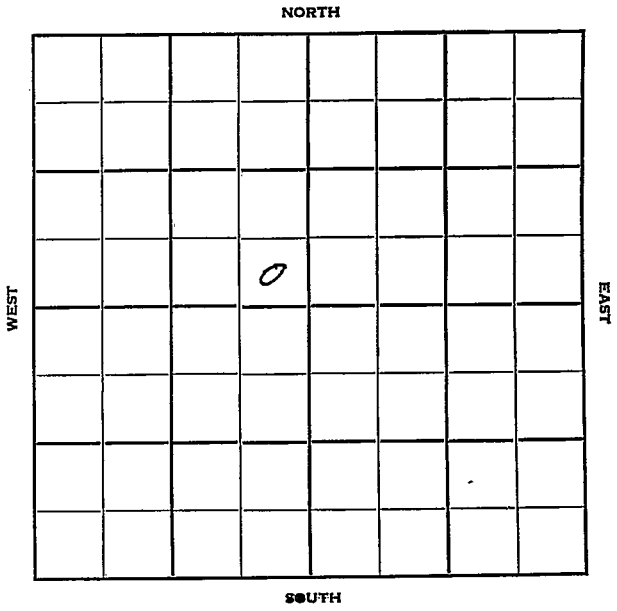

FORM 252-B
10M 11-50 PETROL

Rice KANSAS

Sec. 18 Twp. 18 R. 8 W

Well No. # 1 Seimsen Farm

Howard Hogan - et al Company

Black Contractor

Wildcat


____ Ft. from N. Line

330 Ft. from S. Line

330 Ft. from E. Line

____ Ft. from W. Line

SE SE NW

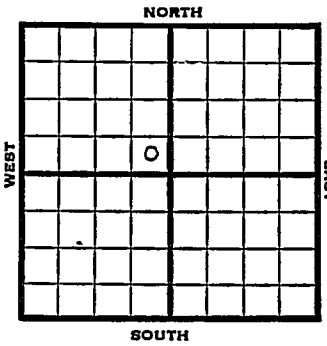

1951	Elev. 1759' REPORT
6/13	MIM
7/18	Spud 6-13-51 D&A TD 3455 8" @ 240 Lans. 2899 DST 2920-35 opn ½ hr Rec. 60' ocm Arb. 3443 TD 3455 5" @ 3150 48/2920-35 1500 A 24/2900-12 2500 A D&A ABANDONED

FORM 275 FOR SALE BY KANSAS BLUE PRINT CO.


County Rice State Kansas

Sec. 18 (Blk. / Twp.) 18 (Sur. / Rge.) 8W Map No.

Operator Howard Hogan - etal

Well No. 1 Farm Seimsen

Elev. Location SE SE NW

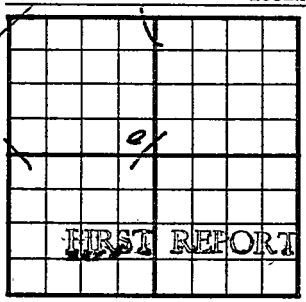

330 Ft. From S Line NW

330 Ft. From E Line Quarter

Ist. Report JUN 13 1951

Completion

Remarks

Black - Contractor

Spudding Date

Drlg. Data

Nim. Wildcat

J. E. TYRA

FORM 275 FOR SALE BY KANSAS BLUE PRINT CO.


County Rice State Kansas

Sec. 18 (Blk. Twp.) 18 (Sur. Rge.) 8W Map No.

Operator Howard Hogan etal.

Well No. 1 Farm Seimsen

Elev. 1759 Location SE SE NW

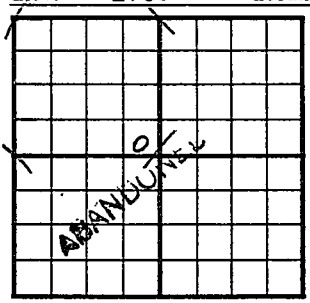

330 Ft. From S Line NW

330 Ft. From E Line Quarter

1st. Report

Completion JUL 1 8 1951

Remarks Wildcat

Black - Contr.

Spudding Date 6-13-51

Drlg. Data D & A TD 3455

8" @ 240 Lans. 2899 DST 2920-35

open ½ hr. Rec. 60' ocm Arb. 3443

TD 3455 5" @ 3150 48/ 2920-35 1500 A

24/ 2900-12 2500 A

D & A

J. E. TYRA