

Rice


FORM 51

KANSAS

Section 23 Township 18 Range 8W

Well No. 2 - Gibson

Company Stagg Drlg

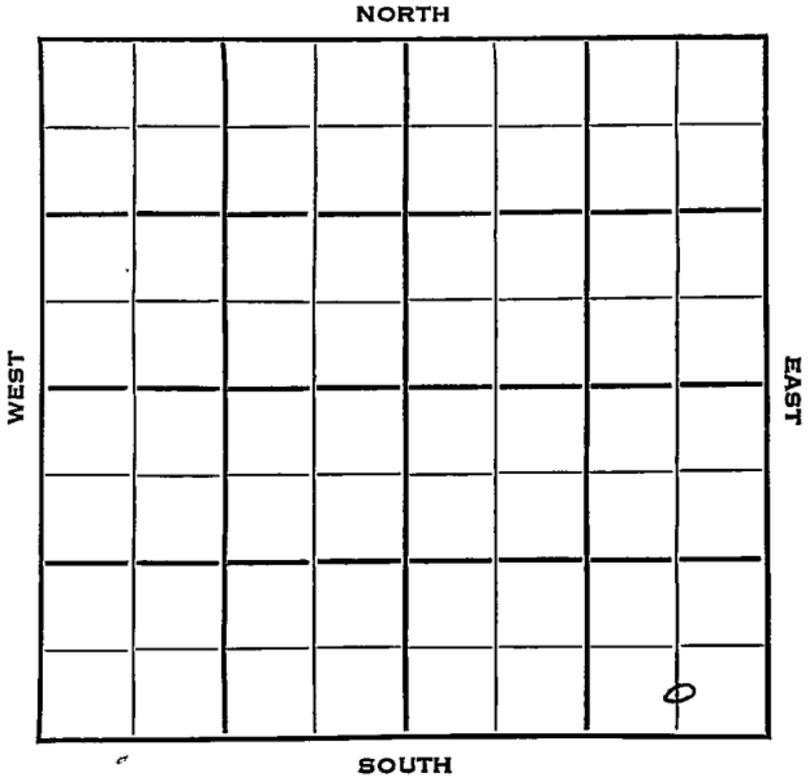

Rice

Sec. 23 Twp. 18 R. 8W

Well No. #2 Gibson Farm

Stagg Drlg. Company

Stagg Drlg. Contractor

Ft. from N. Line

330


Ft. from S. Line

660

Ft. from E. Line

Ft. from W. Line

C S L SE SE

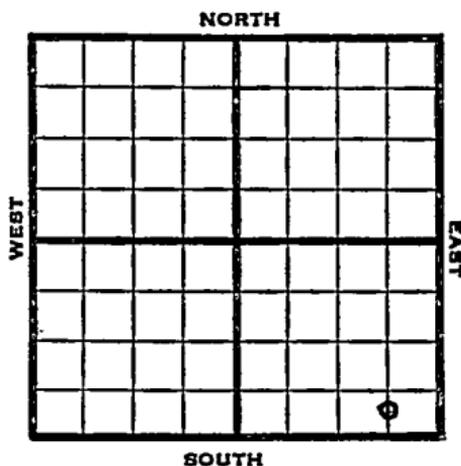

1952 Elev. 1734' REPORT

12/23 Spud 12-22-52

12/25 Location

1/1 Heeb 2683 Br1 2811 Lans 2840 BKC 3159
Cong 3200 Simp 3215 Arb 3239 RTD 3245
5" @ 3240

1/8 CO DD 3246 GU 600' Oil 5 Hrs. 500A
FU 2700' Oil 24 Hrs.

1/22 POP

1/29 "

2/4 Spud 12-22-52

OilWell

TD 3246

8" @ 207

Heeb 2683, Br lime 2811, Lans
2840, B KC 3159, Cong 3200, Simp
3215, Arb 3239

TD 3245,

5" @ 3240

DD 3246

FU 600' oil 5 hrs., 500A

FU 2700' oil 24 hrs.

Comp. 107 bopd 46% wtr.

COMPLETED

