

Section 23 Township 18 Range 8 W

Well No. #² Williams

Company Florney & Williams *Francis Raymond*

NORTH

						0	

WEST

EAST

SOUTH

Rice KANSAS

Sec. 23 Twp. 18 R. 8 W

Well No. #3 Williams Farm

Francis Raymond
Florney & Williams Company

Florney-Williams Contractor

Genesoa


990 Ft. from N. Line

Ft. from S. Line

660
990 Ft. from E. Line

Ft. from W. Line

~~SW NE NE~~
CSL NE NE

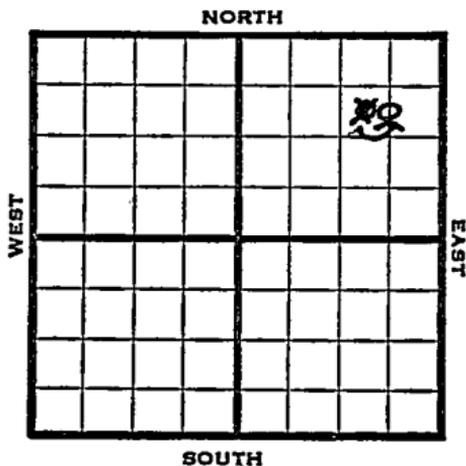

1952 Elev. 1743' REPORT

1/16 Location
2/6 TD 3210'
7" @ 3209', tstg.

2/13 No report

2/20 Spud 1-16-52
Oil well TD 3225' 8" @ 204'
Br. line 2795' Lans. 2823'
Cong. 3142' Arb. 3207' 7" @ 3209'
TD 3210'
DST 3140-64 open 1/2 hr. rec 30' mud
DST 3167-94, open 1/2 hr. rec 17' mud
DD 3225' FU 3075' oil
S/40 BO 1 hr.
Comp. 3000 BOPD

COMPLETED

Map No. _____ Sec. 23 Twp. 18 R. 8W

Well No. 2 Willems

Francis Raymond Company

CORRECTION

Contractor

C S L NE NE

SECTION PLAT

990 Ft. from N. Line

_____ Ft. from S. Line

660 Ft. from E. Line

_____ Ft. from W. Line

			0

Rice County

Location _____

Rig up _____

Drilling and Remarks:

Reported
~~#3 Williams~~
 Florney Williams
 SW NE NE

RECORD

Cased _____ in., _____ ft.

Sand _____

Gas _____

Oil _____

Total Depth _____

PRODUCTION

1st 24 hrs. Nat. _____

1st 24 hrs. after shot _____

Gas _____ Cu. Ft.

Dry Hole _____

Abandoned _____

Date

JAN 23 1952 19

J. E. TYRA Scout

