


Section 23 Township 18 Range 8W

Well No. #3 Willms

Company Francis Raymond

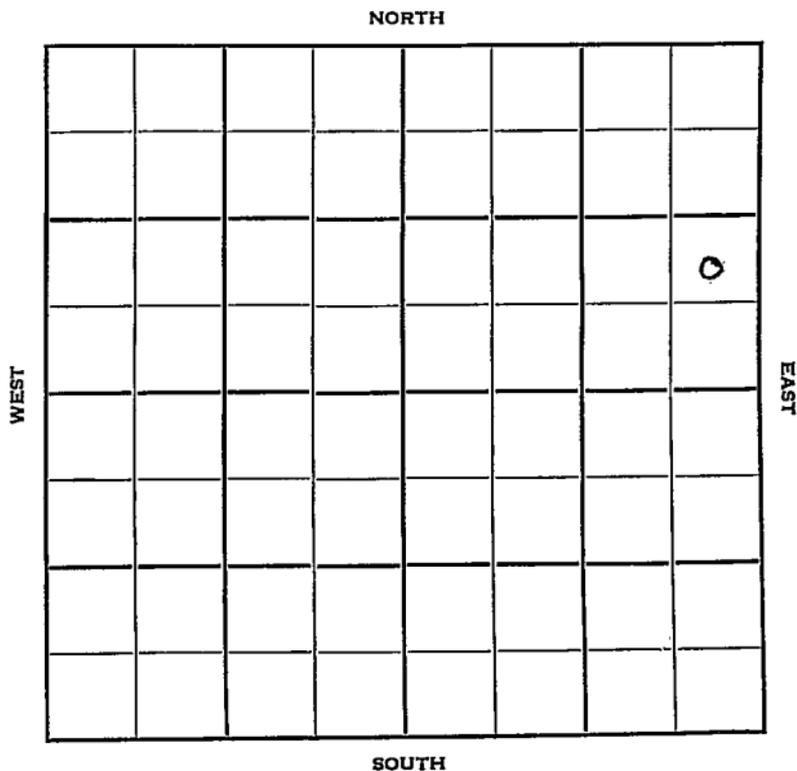

Rice

KANSAS

Sec. 23 Twp. 18 R. 8W

Well No. #3 Willms Farm

Francis Raymond Company

StrainDrlg. Contractor


_____ Ft. from N. Line

990 Ft. from S. Line

330 Ft. from E. Line

_____ Ft. from W. Line

NE $\frac{1}{4}$ NE SE NE

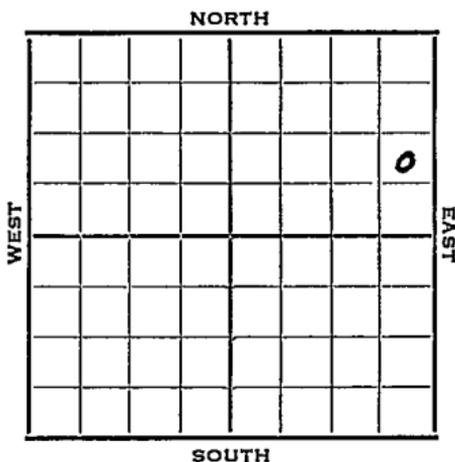

1952 Elev. 1743' REPORT

10/22 Spud 10-12-52
8" @ 245'
Drlg. 3121'

10/29 Arb 3221'
RTD 3223'
5" @ 3223
DD 3226 TD
FU 200' oil 24 hrs.

11/5 1000A - S/24 BOPH - DD 3232'

11/12 Spud 10-12-52
Oil Well
TD 3233'
8" @ 245'
Lans 2819', B KC 3139', Cong.
3171', Simp. 3181, Arb. 3220'
5" @ 3222'
DD 3233 S/27 boph
Comp. 2247 bopd 12% wtr.

COMPLETED

County Rice State Kansas

Sec. 23 (Blk. Twp.) 18 (Sur. Rge.) SW Map No.

Operator Francis Raymond

Well No. 3 Farm Willms

Elev. _____ Location NE SE NE

							0
FIRST REPORT							

990 Ft. From S Line NE

330 Ft. From E Line Quarter

Ist. Report OCT 22 1952

Completion _____

Remarks _____

Strain Drlg. - Contr.

Spudding Date 10-12-52

Drlg. Data

8" @ 245 drlg. 3121

