

Rice


KANSAS

Section 23 Township 18 Range 8W

Well No. #1 Godschalk

Company Francis Raymond

NORTH

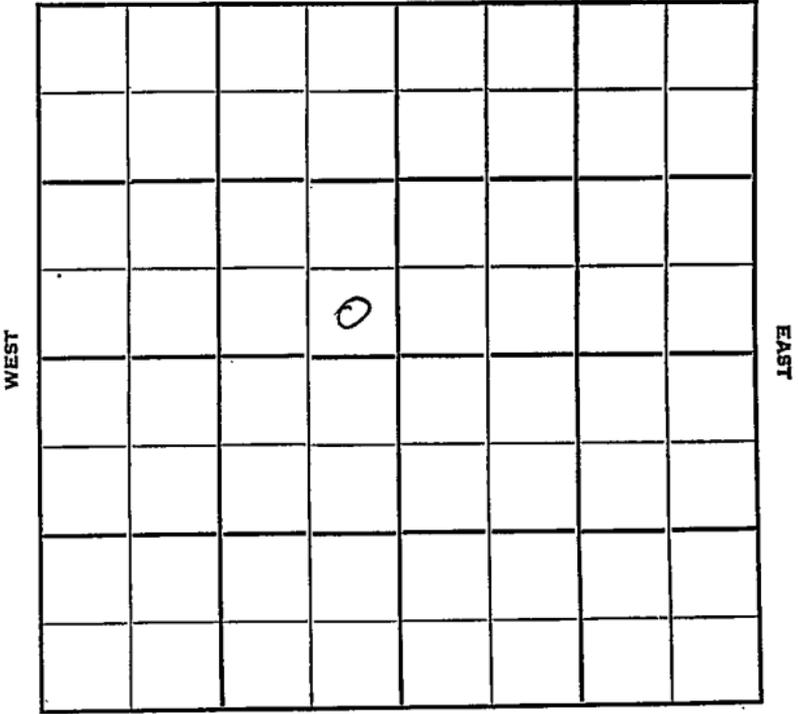

SOUTH

WEST

EAST

Rice

KANSAS

Sec. 23 Twp. 18 R. 8 W

Well No. # 1 Godschalk Farm

Francis Raymond Company

Contractor


_____ Ft. from N. Line

330 Ft. from S. Line

330 Ft. from E. Line

_____ Ft. from W. Line

SE SE NW

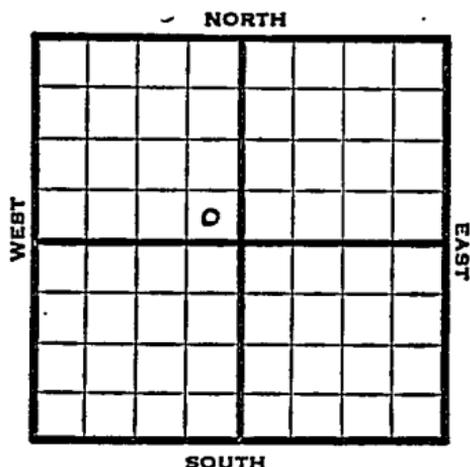

1951

Elev. 1757' REPORT

11/7

Pits

11/21

Spud 11-3-51

D&A TD 3302

8" @ 251

Heeb. 2740 Br Lime 2868

Lans. 2901 Cong. 3244

DST 3244-75 opn 1 hr.

Rec. 10' mud 40' sw

TD 3302 D&A

ABANDONED


County Rice State Kansas

Sec. 23 (Blk. Twp.) 18 (Sur. Rge.) 8W Map No.

Operator Francis Raymond

Well No. 1 Farm Godschalk

Elev. _____ Location SE SE NW

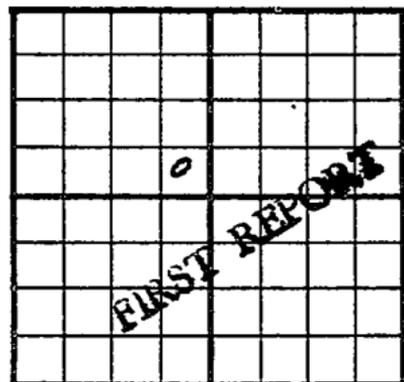

330 Ft. From S Line NW

330 Ft. From E Line Quarter

Ist. Report NOV 7 1951

Completion _____

Remarks _____

Spudding Date _____

Drlg. Data _____

Pitts

J. E. TYRA

County Rice State Kansas

Sec. 23 (Blk. Twp.) 18 (Sur. Rge.) 8W Map No.

Operator Francis Raymond

Well No. 1 Farm Godschalk

Elev. 1757 Location SE SE NW

		0			

330 Ft. From S Line NW

330 Ft. From E Line Quarter

1st. Report

Completion NOV 21 1951

Remarks

Spudding Date 11-3-51

Drilg. Data D & A TD 3302

8" @ 251 Heeb. 2740 Br. lime 2868

Lans. 2901 Cong. 3244 DST 3244-75

open 1 hr. Rec. 10' mud 40' sw

TD 3302 D & A

J. E. TYRA